
DEVELOPMENT PLAN FOR GENERAL NOTES: LA CANADA/LAMBERT APARTMENTS 1. THE GROSS AREA OF THIS DEVELOPMENT IS 13.09± ACRES. A PORTION OF BLOCK 3, EL CONQUISTADOR COUNTRY CLUB, NET BUILDING AREA =  $2.11 \pm$  ACRES. AS RECORDED IN BOOK 33 M&P, PAGE 82, PIMA COUNTY RECORDER'S OFFICE, PIMA COUNTY, AZ.  $\underbrace{MINIMUM AREA OF LANDSCAPE OPEN SPACE REQUIRED = 0.95 ACRES (7.26%)}_{(RESIDENTIAL UNITS = 138 154}$ 2. EXISTING ZONING: EL CONQUISTADOR P.A.D. - COMMERCIAL. WALL SAMARAK 30 որաց հայ A A STRATE IN A CONTRACT STRATE AND A CONTRACT STRATE 3. BUILDING SQUARE FOOTAGES (ALL FLOORS): BLDG. "1" - 16.646 SF BLDG. "2" - 16,646 SF K. 8, PG. 57, ROAD MAPS BLDG. "3" - 11,432 SF BLDG, "4" - 18.142 SF EK. 8, BLDG. "5" – 18.142 SF BLDG. "6" - 11,432 SF 517.30'-S 89'56'20" W BLDG. "7" - 9,858 SF BLDG. "8" – 16,568 SF BLDG. "9" - 14,416 SF BLDG. "10" - 14,416 SF SHOPS #1 - 13,200 SF S SHOPS #2 - 12,687 SF [145] SHOPS #1 ¶ă ₹ CLUBHOUSE – 3,192 SF BLDG. "11" <del>RÉSTAURANT – 5,000</del> SF\_27,635 SF\_ EXIST. OSCO BUILDING 1335 DP. BK. 22, PG. 23 **DAD** OAD TOTAL: <u>181,777</u> SF 204,412 SF BLDG. "11" 185 AROAD ROAD ROAD ROAD AC AS A 4. AMOUNT OF PARKING SPACES ALLOTTED PER BUILDING CANADA PG. 64, RC the second se BLDG. "1" - 32 SPACES N 89'58'25" E 290.90' BLDG. "2" - 32 SPACES BLDG. "3" – 17 SPACES BLDG. "4" - 27 SPACES BLDG. "5" – 27 SPACES 1301 BLDG. "6" - 17 SPACES LA. HOUSI SUITE BLDG. "7" - 17 SPACES Σ Ä BLDG. "8" - 27 SPACES 10370 BLDG. "9" - 32 SPACES 5366666659 BLDG. "10" – 32 SPACES SHOPS SHOPS #1 - 53 SPACES #2 SHOPS #2 - 51 SPACES CLUBHOUSE - O SPACES BLDG. "11" <del>RÉSTAURANT - <u>25 SPACES</u> 36 SPACES</del> (7) internation of the second s TOTAL= 389 SPACES 400 SPACES / HANDICAP REQUIRED=14 SPACES (2 VAN-ACCESSIBLE) BLDG. y 1. BEDG Ē PARKING SPACES PROVIDED: TYPICAL =4<del>25 SPACES</del> 413 SPACES HANDICAP =17 SPACES (13 SINGLE, 4 VAN ACCESSIBLE) TOTAL =446 SPACES 430 SPACES BUILDIN Same of a BANK , <sup>2</sup> - 6 DP. BK. 25, PG. 30 na tagy the n. M 3 BASIS OF BEARING: THE NORTH LINE OF THE NW QUARTER OF SECTION 14, BLDG. 9 BLDG. T-12-S, R-13-E, ACCORDING TO EL CONQUISTADOR COUNTRY CLUB, BLOCKS 1 THRU 3, AS RECORDED IN BOOK 33 M&P, PAGE 82. BEARING BEING: N 89" S 89 56'20" W 62.00 56'20" E S 89'56'20" W 746.33 6. BASIS OF ELEVATIONS: PIMA COUNTY DOT/ CITY OF TUCSON DOT GEODETIC ∑<u>IS 00°03′15" E</u> 70.00′ CONTROL POINT E21. ELEVATION BEING: 2693.76 NAVD 88 DATUM. A DES OF LA CANADA 7. DEVELOPER WILL COVENANT TO HOLD TOWN OF ORO VALLEY. ITS SUCCESSORS AND ASSIGNS, HARMLESS IN THE EVENT OF FLOODING. 8. DRAINAGE WILL NOT BE ALTERED, DISTURBED OR OBSTRUCTED WITHOUT THE 29. THE SOILS ENGINEER OF RECORD OR OTHER REGISTERED CIVIL ENGINEER WITH EXPERTISE APPROVAL OF THE ORO VALLEY TOWN COUNCIL. 18. ANY WASTEWATER DISCHARGED INTO THE PUBLIC SANITARY SEWER IN THE AREA OF SOILS ENGINEERING SHALL CERTIFY, IN WRITING, THAT ALL SOILS OPERATIONS SYSTEMS SHALL MEET THE REQUIREMENTS OF INDUSTRIAL WASTE ORDINANCE FOR THIS DEVELOPMENT WERE PERFORMED IN ACCORDANCE WITH THE RECOMMENDATIONS AS 9. DRAINAGE WAYS AND/OR DRAINAGE SYSTEMS TO BE CONSTRUCTED (PIMA COUNTY ORDINANCE NO. 1991-140 AS AMENDED). SET FORTH IN THE GEOTECHNICAL INVESTIGATION BY TERRACON, JOB NO. 63995016, DATED ACCORDING TO APPROVED PLANS PRIOR TO THE ISSUANCE OF ANY BUILDING AF'RIL 6, 1999, AND ANY ACCEPTED ADDENDA/AMENDMENTS UTILIZED ON THIS DEVELOPMENT PERMITS FROM THE TOWN OF ORO VALLEY AND/OR BUILDING OFFICIAL. 19. ON-SITE TRAVEL LANES DESIGNED FOR SU-30 VEHICLE, DESIGN SPEED ARE IN CONFORMANCE WITH THE TOWN ENGINEER OF THE TOWN OF ORO VALLEY PRIOR TO THE EQUALS 15 MPH. REQUEST FOR ANY BUILDING PERMITS AND/OR FINAL INSPECTION AND THE RELEASE OF 10. A PROPERTY OWNERS ASSOCIATION WILL BE FORMED TO ACCEPT 20. APPROVED IMPROVEMENT PLANS AND APPROVED ASSURANCES WILL BE RESPONSIBILITY FOR MAINTENANCE, CONTROL, SAFETY, AND LIABILITY OF PRIVATE ASSURANCES. DRAINAGE WAYS, DRAINAGE EASEMENTS AND COMMON AREAS. REQUIRED PRIOR TO ISSUANCE OF GRADING PERMITS. 30. ARCHAEOLOGICAL CLEARANCE AND TRAFFIC IMPACT ANALYSIS WILL BE PROVIDED BY THE 11. ACCESS ACROSS FLOOD PRONE AREAS TO BUILDING SITES WILL BE APPROVED 21. ANY RELOCATION. MODIFICATION. ETC. OF EXISTING UTILITIES AND/OR DEVELOPER. BY THE TOWN ENGINEER AND SHALL BE THE RESPONSIBILITY OF THE DEVELOPER. PUBLIC IMPROVEMENTS NECESSITATED BY THE PROPOSED DEVELOPMENTS 31. THE DEVELOPER IS RESPONSIBLE FOR PROVIDING 1% OF THE COST OF ON-SITE PRIVATE WILL BE AT NO EXPENSE TO THE PUBLIC. 12. DEVELOPMENT PLANS WILL BE SUBMITTED FOR THE COMMERCIAL LOTS OR PROJECTS TO FUND PUBLIC ART. PADS PRIOR TO THE ISSUANCE OF ANY PERMITS BY THE TOWN ENGINEER AND/OR 22. A PROJECT CONSTRUCTION PERMIT SHALL BE SECURED FROM PIMA 32. MINIMUM BUILDING CONSTRUCTION TYPE IS V-B. BUILDING OFFICIAL. COUNTY WASTEWATER MANAGEMENT DEPARTMENT WHEN CONNECTION IS MADE TO A NEW OR EXISTING PUBLIC MANHOLE BEFORE BEGINNING ANY 13. THE FOLLOWING UTILITIES WILL PROVIDE SERVICE TO THIS DEVELOPMENT: WORK ON THIS PROJECT. 33. STAIR STEPS OR ADA RAMPS @ 8.3% GRADE W/ HANDRAILS MAY BE NECESSARY ON SIL)EWALKS ACCESSING THE SIDE DOORS OF THE RESIDENTIAL UNIT GARAGE AREAS. (A) ELECTRIC – TUCSON ELECTRIC POWER COMPANY 23. THE PROPERTY OWNERS, THEIR SUCCESSORS OR ASSIGNS AGREE TO: (B) GAS – SOUTHWEST GAS CORPORATION 34. A MINIMUM OF 11 RESIDENTIAL GROUND FLOOR UNITS WILL BE ADA ACCESSIBLE. ONE 1) KEEP ALL REQUIRED LANDSCAPED AREAS MAINTAINED IN A (C) WATER - ORO VALLEY WATER UTILITY UNIT EACH IN BUILDINGS 1 THROUGH 4 AND BUILDINGS 6 THROUGH 10 WILL BE PROVIDED. TWO WEED FREE, TRASH FREE CONDITION, (D) SEWER - PIMA COUNTY WASTEWATER MANAGEMENT UNITS IN BUILDING 5 WILL BE PROVIDED. 2) REPLACE ANY DEAD PLANT MATERIALS WITHIN 30 DAYS, AND (E) TELEPHONE - QWEST COMMUNICATIONS 3) MAINTAIN THE IRRIGATION SYSTEM IN PROPER WORKING ORDER. (F) FIRE PROTECTION - RURAL METRO FIRE DEPARTMENT 35. THE DEVELOPER IS RESPONSIBLE FOR: (G) CABLE TELEVISION - JONES INTERCABLE (A) PROVIDING A FIRST FLUSH SYSTEM ACCEPTABLE TO THE TOWN ENGINEER 24. PROPOSED WATER LINES ARE WITHIN ZONE "D". (B) PROVIDING A STRIPING AND PAVEMENT WIDENING DESIGN OF LAMBERT 14. THIS PROJECT WILL BE SERVED BY THE ORO VALLEY WATER UTILITY WHICH LANE ACCEPTABLE TO THE TOWN ENGINEER 25. MAXIMUM BUILDING HEIGHT = 38 FEET. HAS BEEN DESIGNATED AS HAVING AN ASSURED 100 YEAR WATER SUPPLY BY (C) ENSURING THAT ALL ADA SIDEWALK RAMPS TO BUILDINGS MEET ADA STANDARDS THE DIRECTOR OF WATER RESOURCES. 26. SETBACKS: 20 FEET, 25 FEET FROM P.A.D. BOUNDARY. (D) ENSURING THAT THE MAXIMUM CROSS SLOPE FOR STANDARD PARKING SPACES DOES NOT EXCEED 5% 15. REQUIRED FIRE FLOW FOR THIS DEVELOPMENT IS 1,500 G.P.M. 27. THE DEVELOPER SHALL BE RESPONSIBLE FOR THE CONSTRUCTION OF (E) ENSURING THAT THE MAXIMUM CROSS SLOPE IN ADA ACCESSIBLE ALL BUILDINGS SHALL HAVE AN AUTOMATIC SPRINKLER SYSTEM INSTALLED. THE SIDEWALK ON LA CANADA DRIVE. ROUTES DOES NOT EXCEED 2% 16. ON-SITE SANITARY SEWERS EXCEPT PUBLIC SEWERS WITHIN PUBLIC SEWER 28. THE DEVELOPER SHALL BE RESPONSIBLE FOR THE CONSTRUCTION OF EASEMENTS OR RIGTHS-OF-WAY SHALL BE PRIVATE AND WILL BE CONSTRUCTED, THE TRAIL HEAD AREA, AND OFF-SITE CONNECTION TO THE LAMBERT LANE CONTINUED ON SHEET 8 OPERATED AND MAINTAINED ON A PRIVATE BASIS. THE LOCATION AND METHOD MULTI-USE PATH, IN ACCORDANCE WITH AASHTO STANDARDS. OF CONNECTION TO AN EXISTING PUBLIC SANITARY SEWER IS SUBJECT TO REVIEW AND APPROVAL BY PIMA COUNTY WASTEWATER MANAGEMENT DEPARTMENT AT THE TIME OF SUBMITTAL OR PERFORMING OF BUILDING PLANS. Engineering and Environmental Consultants. Inc. 17. ALL SEWERS WILL BE DESIGNED TO PROVIDE GRAVITY FLOW. 4625 E. FT. LOWELL RD. 3/24/2021 | ORO VISTA APARTMENTS BWT SMT TUCSON, ARIZONA 85712 520-321-4625 DATE REVISION BY CH APPR




PG


- (F) ENSURING THAT THE MAXIMUM CROSS SLOPE FOR ALL SIDEWALKS DOES NOT EXCEED 2%




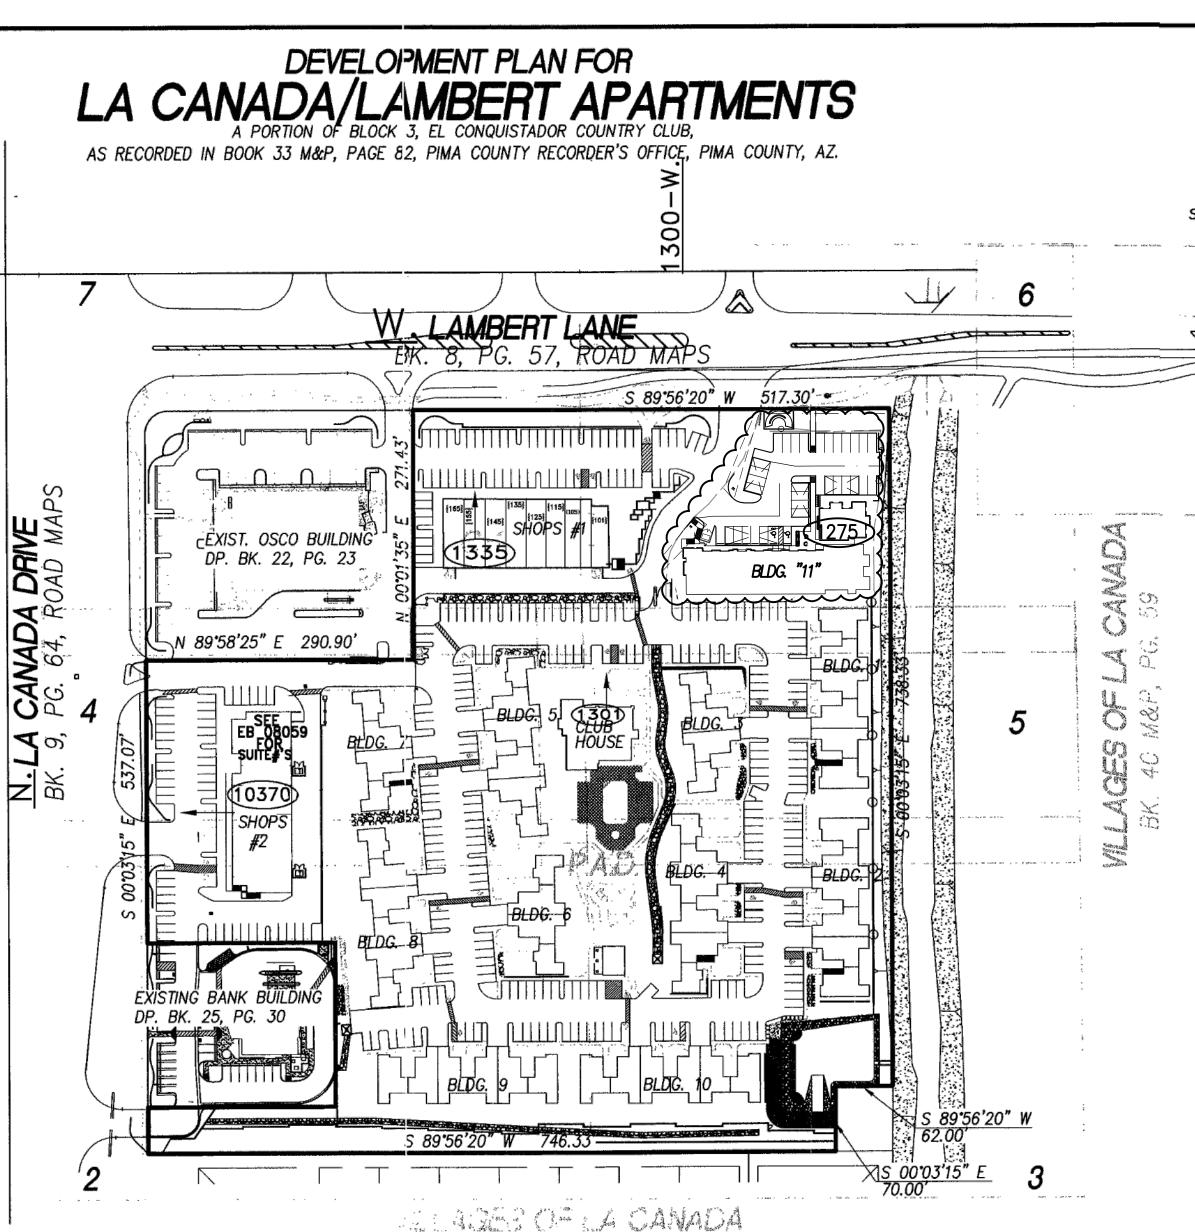



	xxxxxxxxxxxxxxxxxxxxxxxxxxxxxxxxxxxxx	SCALE: 3"=1 MI THIS PROJECT	LE SEC 10 DP 33-62 LAMBERT DP 14-43 SEC 15 SEC 15 J1/92 V V LOCATION MAP PORTION OF SECTION 14, T.12 S., R.13 E. G. & S.R.M., PIMA COUNTY, ARIZONA
	<u>LEGEND</u>		
w	OVERHEAD UTILITY		RETAINING WALL (BY OTHERS)
	CENTERLINE	<u>N72</u>	TEXTURED CONCRETE
Δ.	FOUND SURVEY MONUMENT - AS NOTED		TEXTORED CONOREIE
(R) (M)	RECORD MEASURED		PROPOSED PAVEMENT/MULTI-USE PATH
	PROPOSED WATERLINE AND VALV EXISTING WATERLINE AND VALVE	E	EXISTING PAVEMENT TO BE REMOVED
⊠ ®	WATER METER PROPOSED SANITARY SEWER AND	MANHOLE	EXISTING PAVEMENT/MULTI-USE PATH
	EXISTING SANITARY SEWER AND I PROPOSED STORM SEWER AND M	[2777]	CROSSOVER EASEMENT (DKT 11536, PG 2845)
	FIRE HYDRANT COVERED PARKING	literaturation de	~~~~~~
And the second s	SCREEN WALL W/ WEEP HOLES (	(BY OTHERS)	STORE AND A
plan forta Canada/2	Separt 1 Town Clerk, Town of reby certify that the development ambert Apartments was valley Mayor and Council on the valley May	SHEET SHEET SHEET	STEFANIE M. THRUSH Signed THRUSH THRUSH THRUSH Signed THRUSH Signed THRUSH THRUSH Signed Signed THRUSH Signed S
FIRST FLUSH SY	STEM MAINTENA	NCE	
1.) ALL BUILDING OWNERS AND TENANTS WILL BE NOTIFIED OF A PROHIBITION ON WASHING OF VEHICLES ON SITE.			
			VALLEY SHOPPING CENTER, LLC. THE BEZTAK COMPANIES
A) CONCRETE SWALE WILL BE HYDRO WASHED AND CLEANED OF SILTS, SEDIMENT AND DEBRIS TWICE PER YEAR (JUNE AND OCTOBER RECOMMENDED). GATHERED SILTS AND DEBRIS WILL BE DISPOSED OF IN THE			
TRASH COLLECTION SYSTEM. DEVELOPER   B) THE 6" BLEEDER PIPES TO THE BASIN WILL BE CLEANED OF THE BEZTAK COMPANIES   OBSTRUCTIONS AND DEBRIS AND FLUSHED TO ENSURE FLOW THROUGH 31731 NORTHWESTERN HIGHWAY			
ADEQUACY. SUITE 250W FARMINGTON HILLS, MI. 48334			
3.) FIRST FLUSH TREATMENT BASIN WILL BE CLEANED BY HAND OF DEBRIS TEL: (248) 855-5400 AND TRASH TWICE PER YEAR (JUNE AND OCTOBER RECOMMENDED).			
$\bigwedge$	ENGINEER (REVISION	1 ONLY) > EN	GINEER
	ENGINEERING & ENVIRONMENTAL CO		NEERING & ENVIRONMENTAL CONSULTANTS, INC.
WN OF ORO VALLEY STUCSON, AZ 85704 ATTN: STEFANIE THRUSH, P.E. SOJ#:OV1202-06 STUCSON, AZ 85704 ATTN: STEFANIE THRUSH, P.E. EMAIL: sthrush@eeccorp.com STUCSON, AZ 85704 ATTN: STEFANIE THRUSH, P.E. EMAIL: sthrush@eeccorp.com TEL: (520) 321-4625			SON, ARIZONA 85712 N: RYAN BALE, P.E.
	PHONE: (520) 321–4625 FAX: (520) 321–0333		(520) 321-4625 (520) 321-0333
dm. Address: 0326 N. LA CANADA DR	APARTMEN		$IN + IINIT \mu$
1301 W. LAMBERT LN + UNIT #			
EEC PROJECT NO: 202103 DEVELOPMENT PLAN FOR LA CANADA/LAMBERT APARTMENTS; A PORTION OF BLOCK 3, EL CONQUISTADOR COUNTRY CLUB AS RECORDED IN BK. 33 M&P, PG. 82, PIMA COUNTY 16963 RYAN G. BALE DRWN BY APPD BY20 REFSCALE H: 1*=20' V:			
2014 113	DSGN BY		

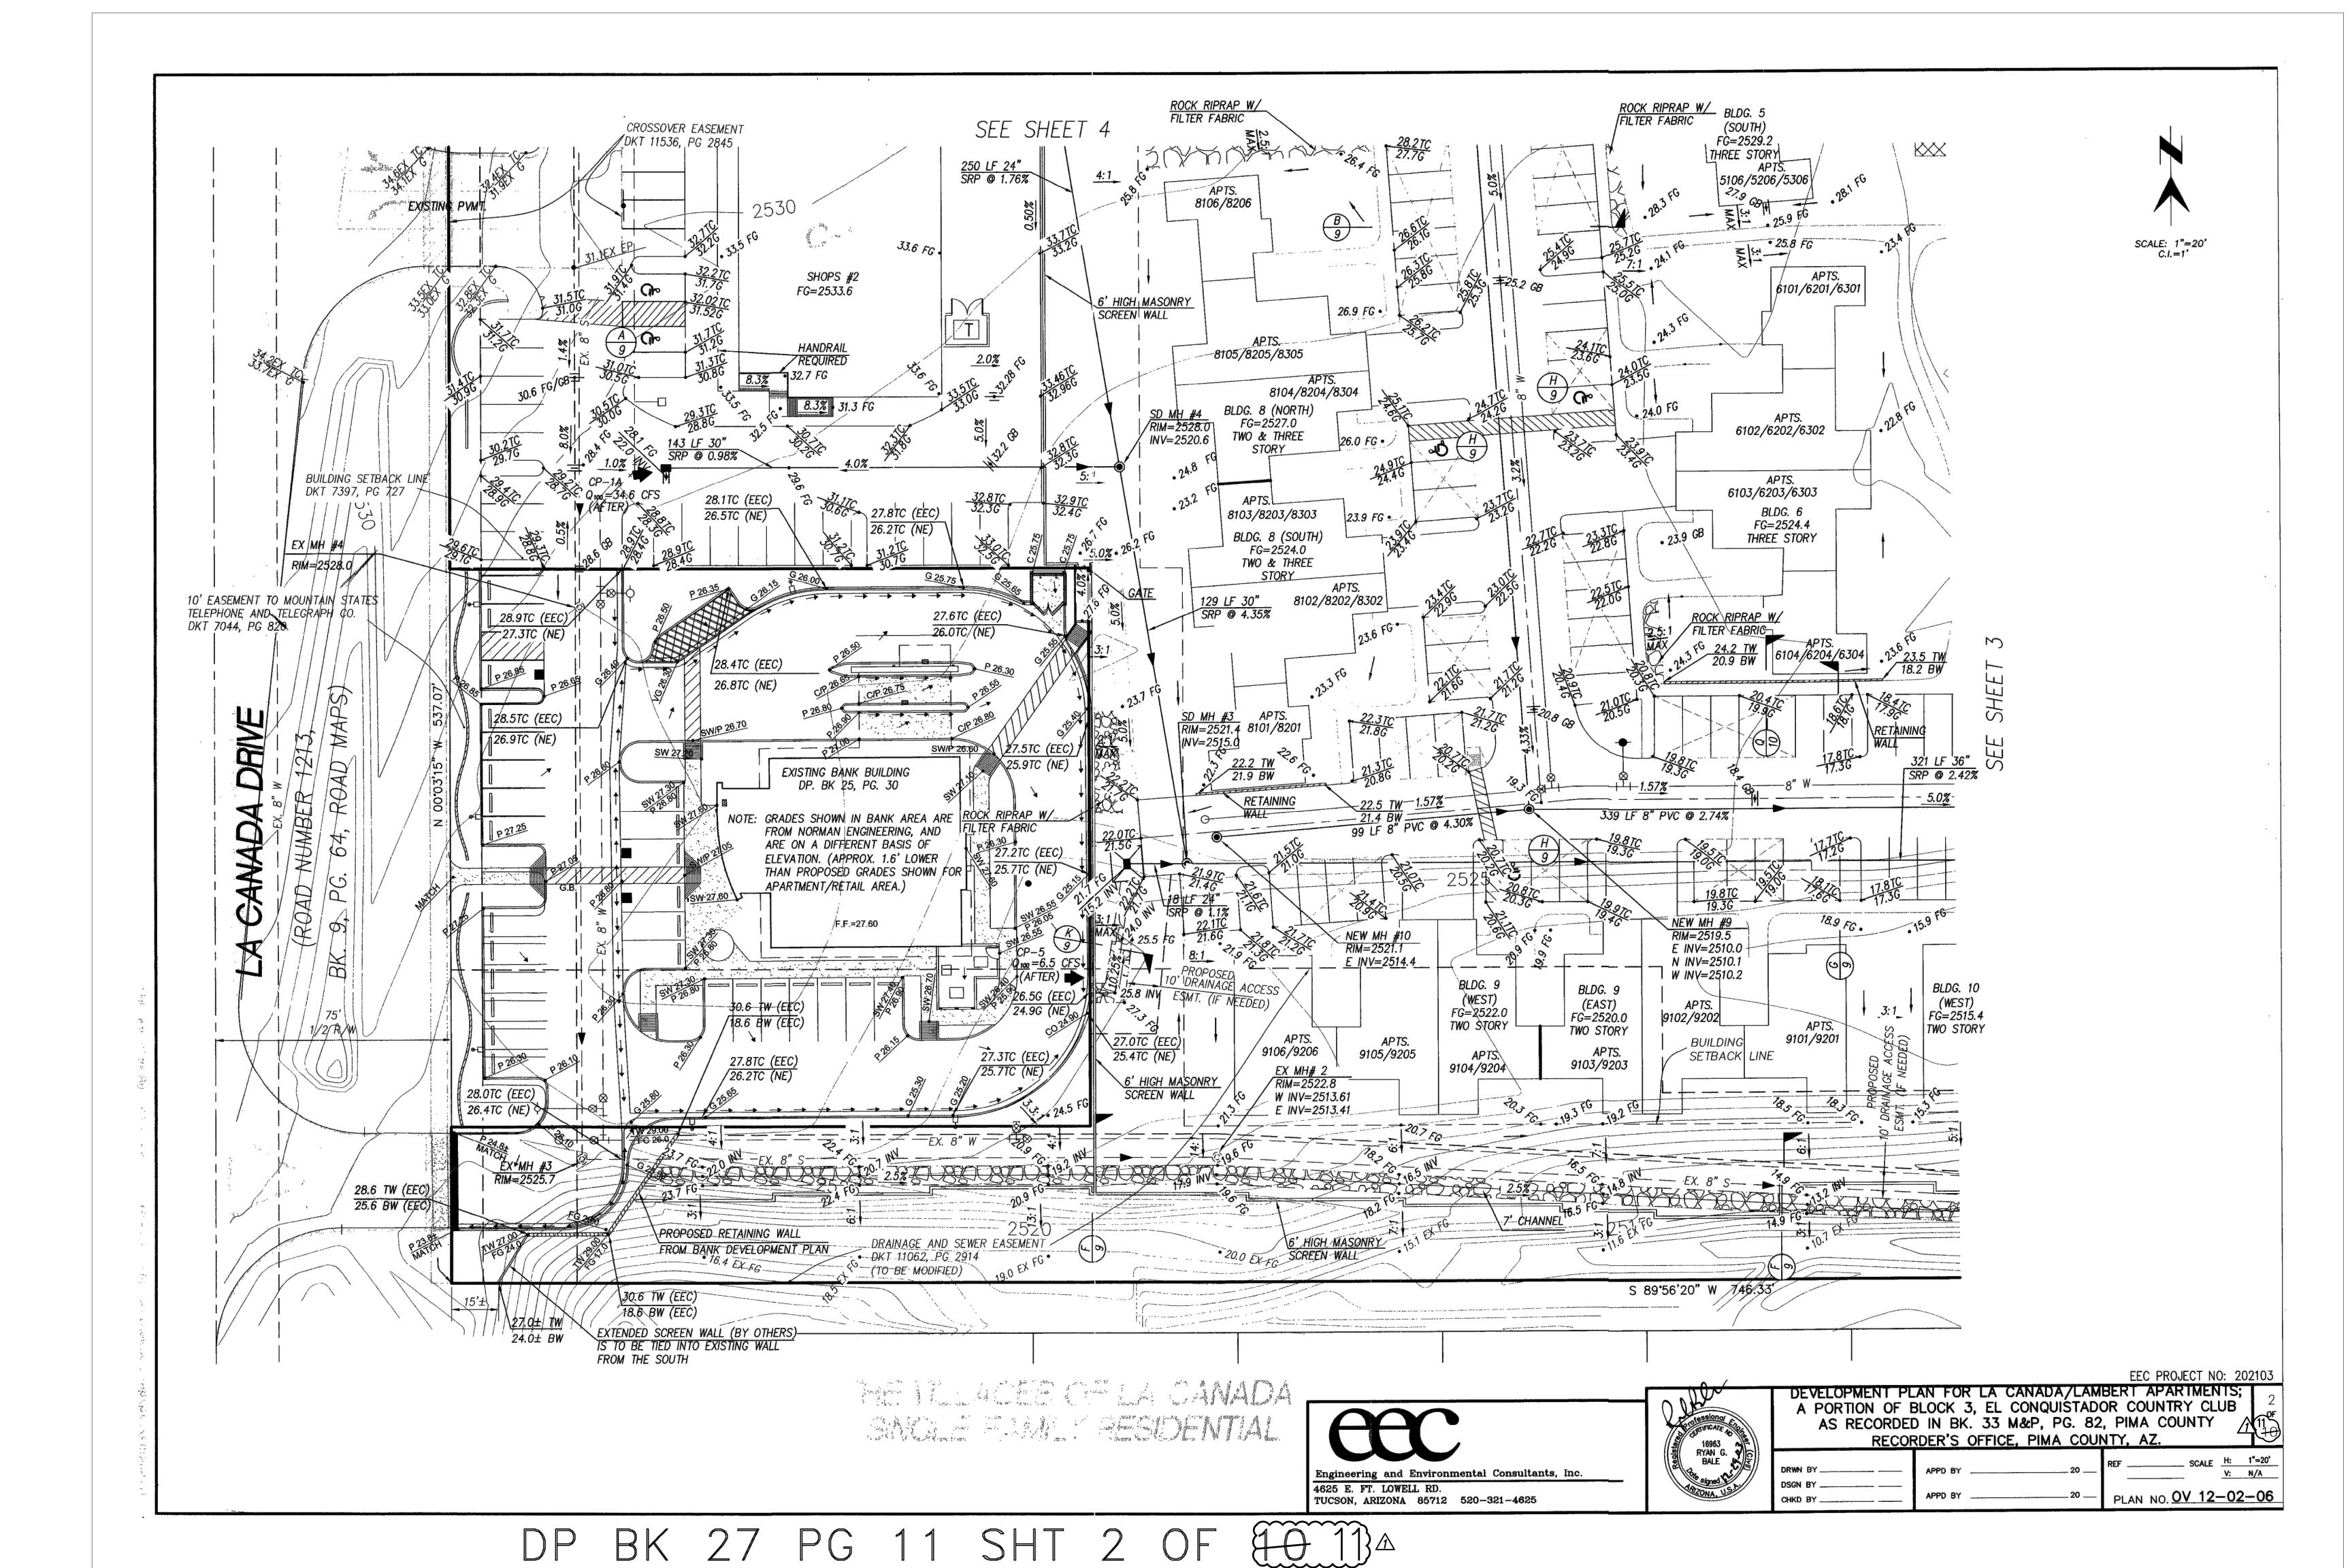


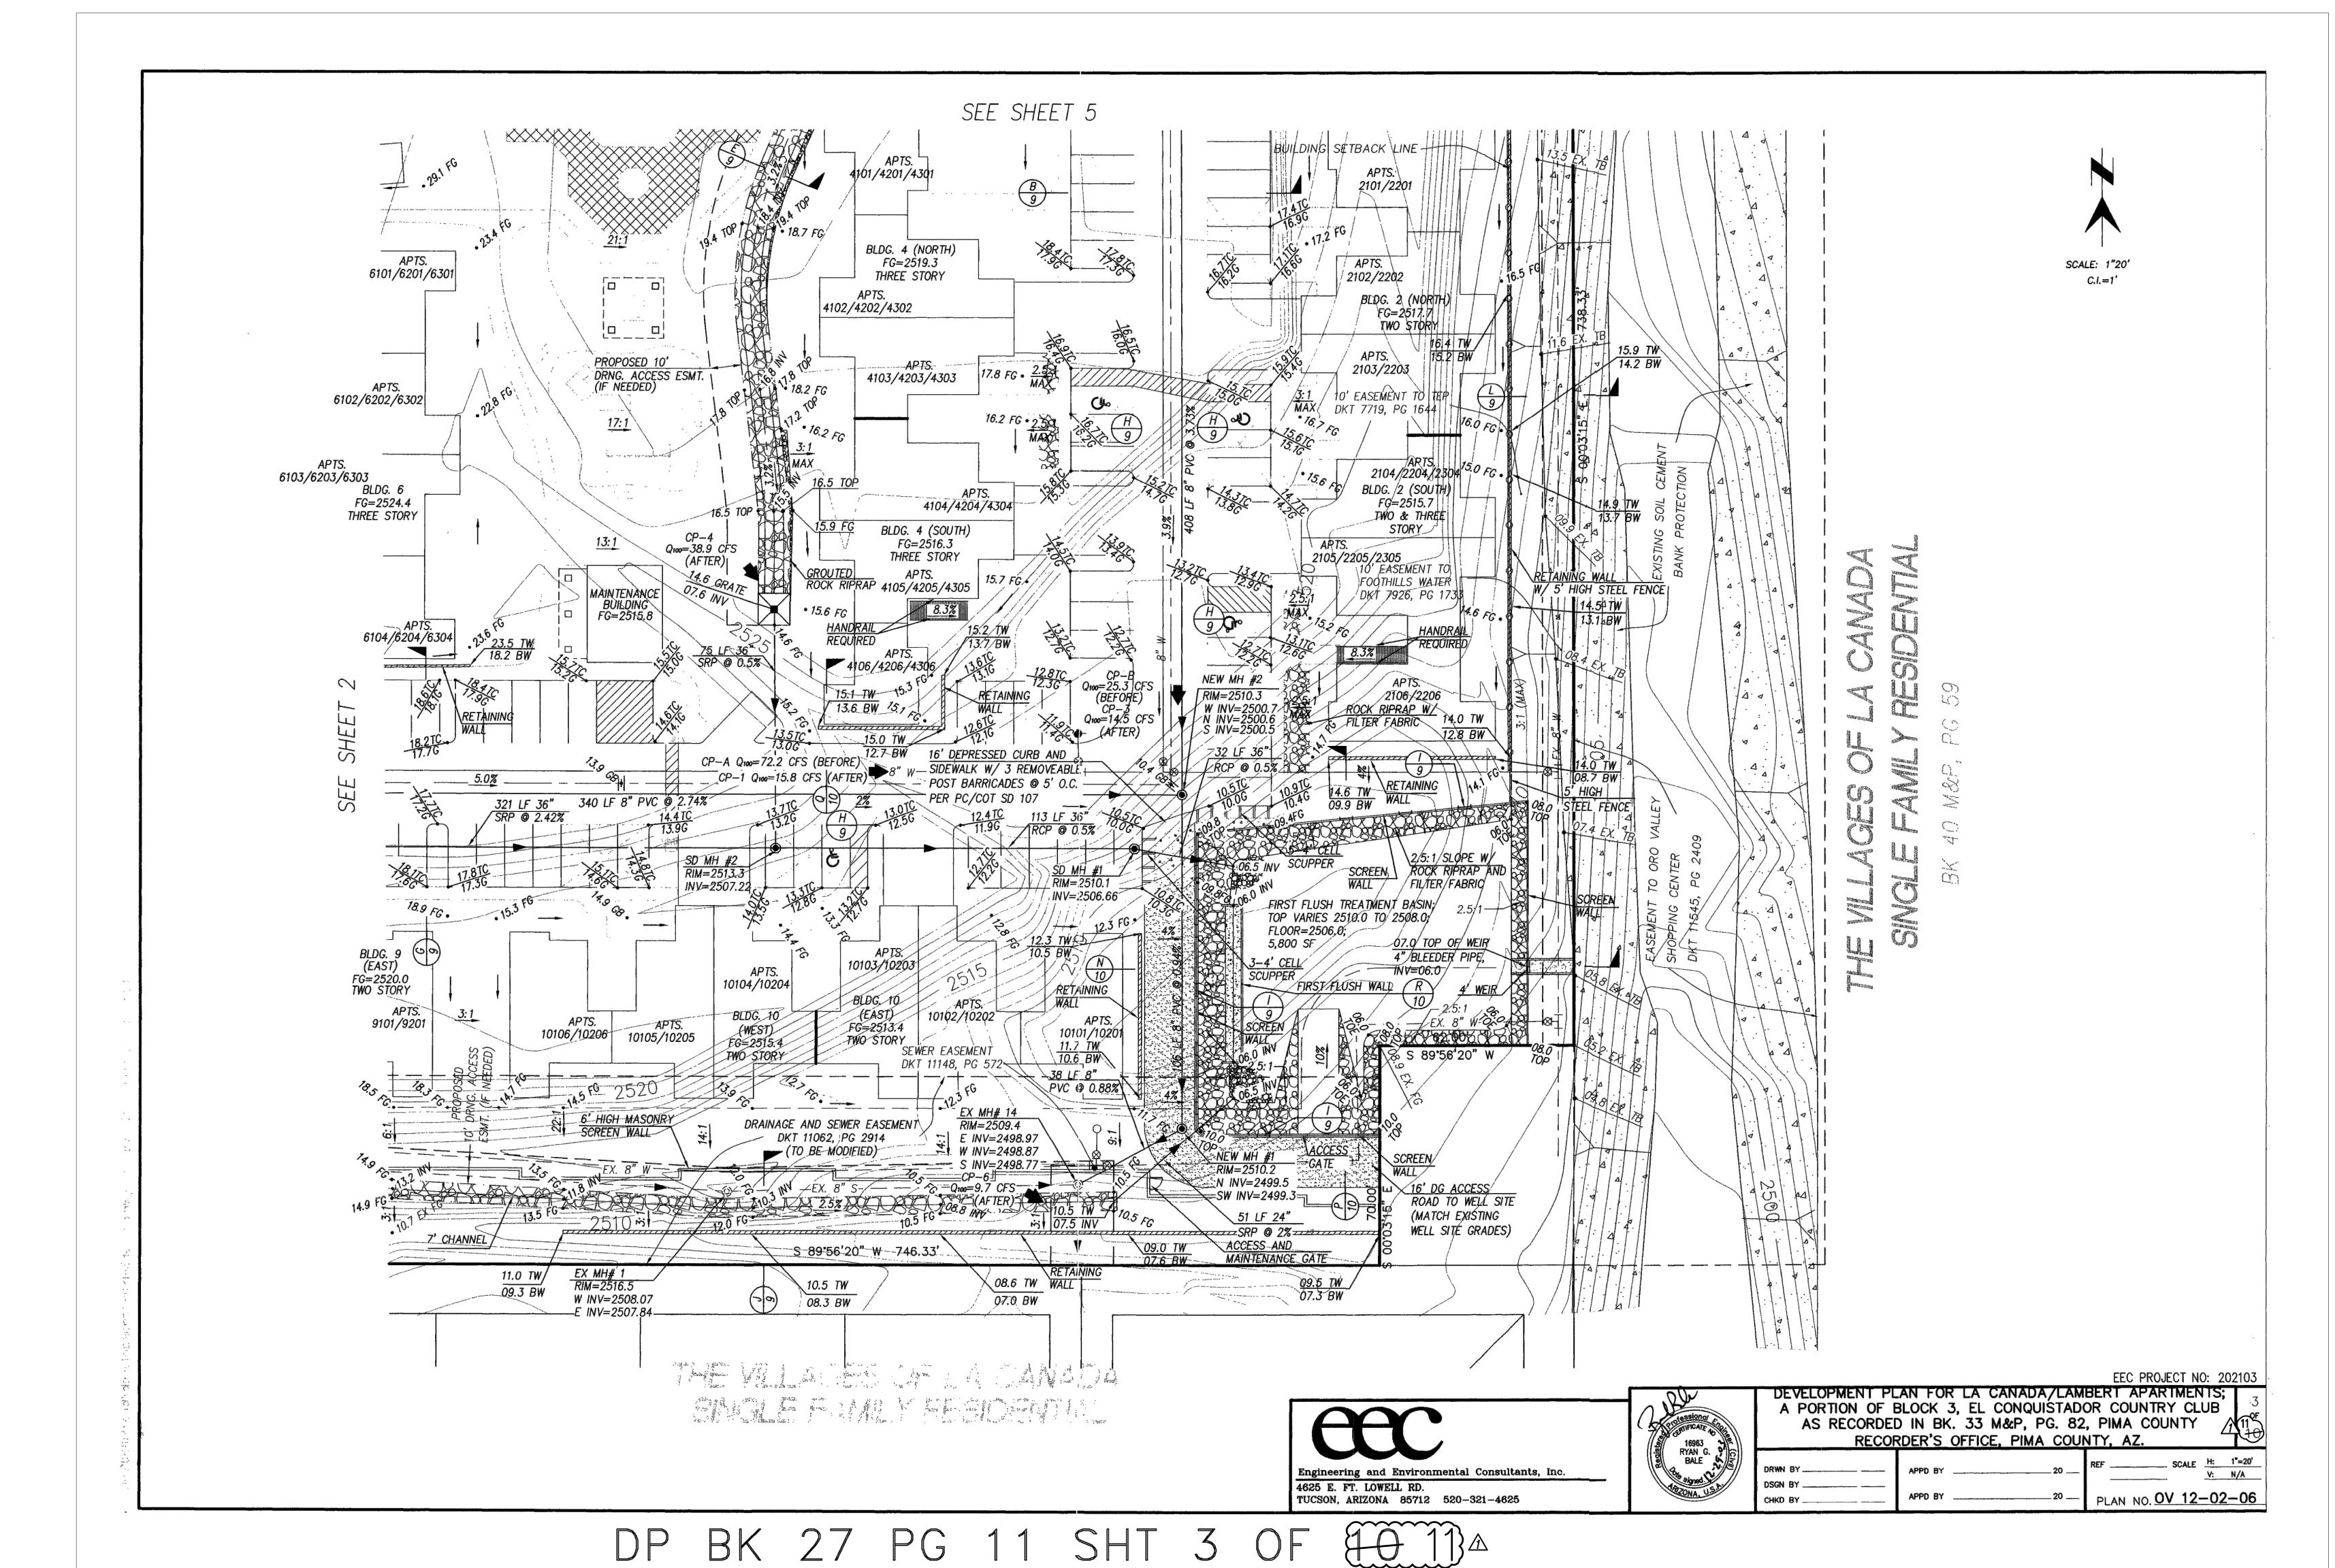


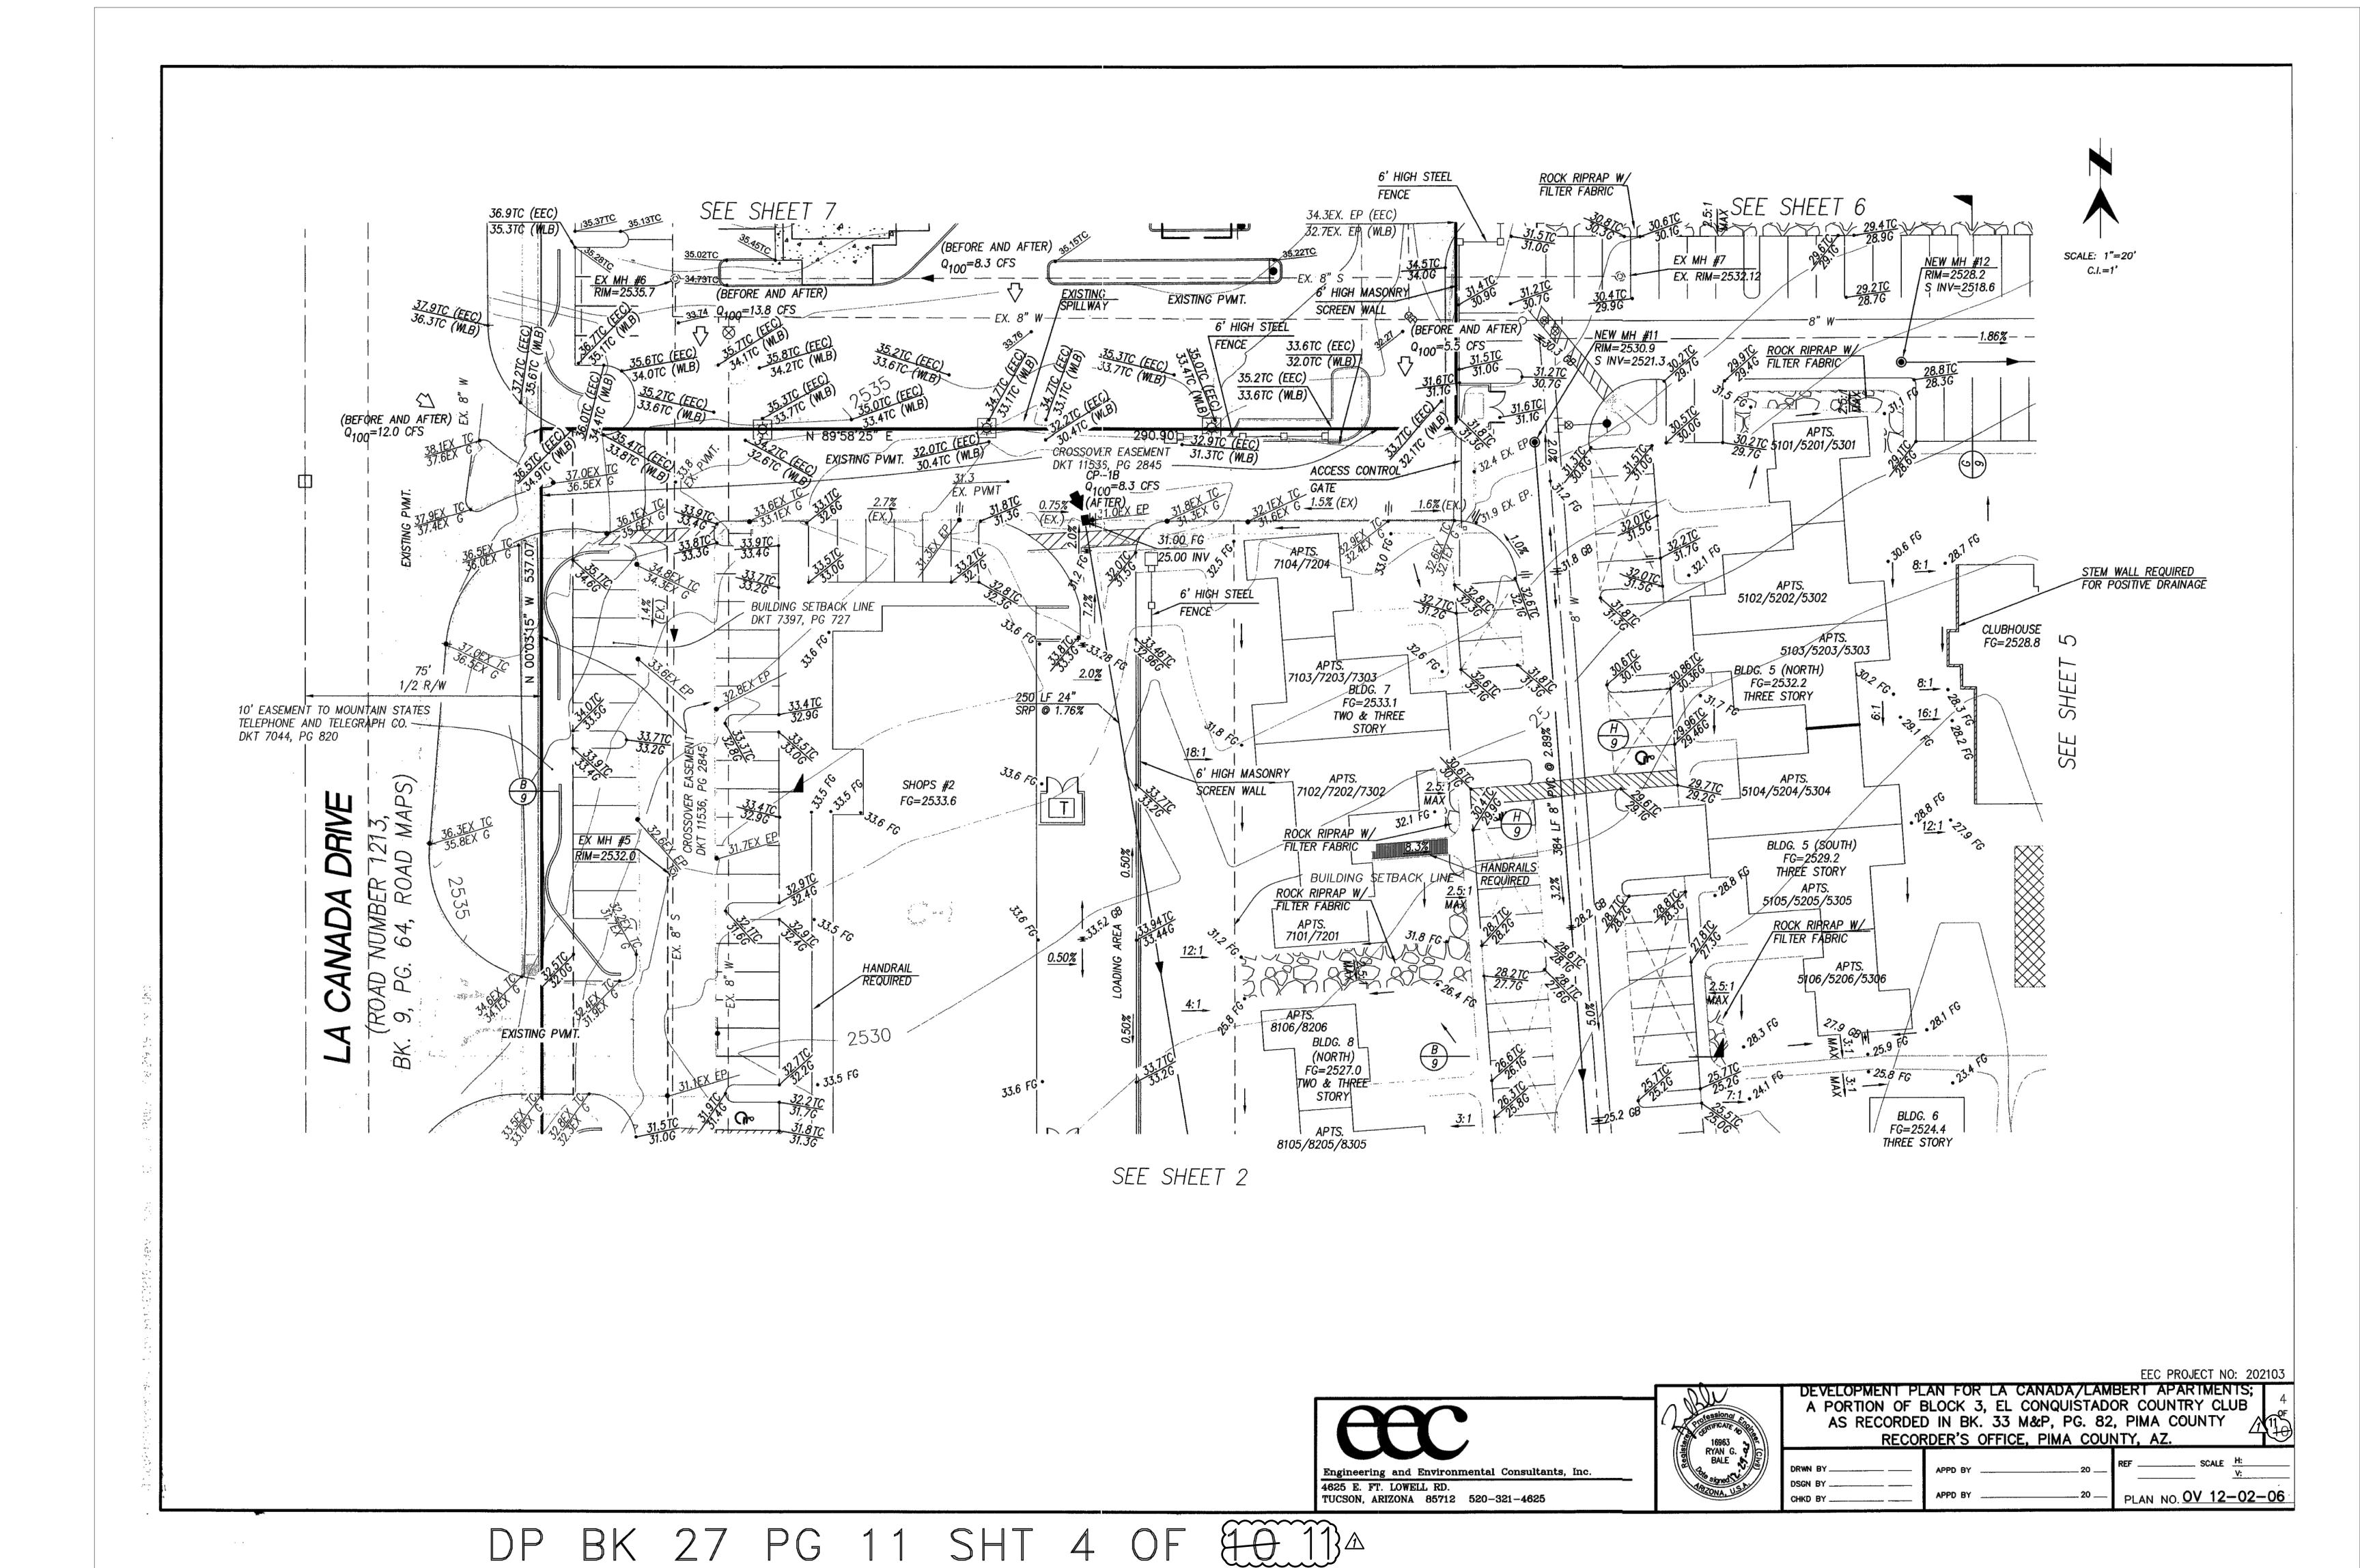

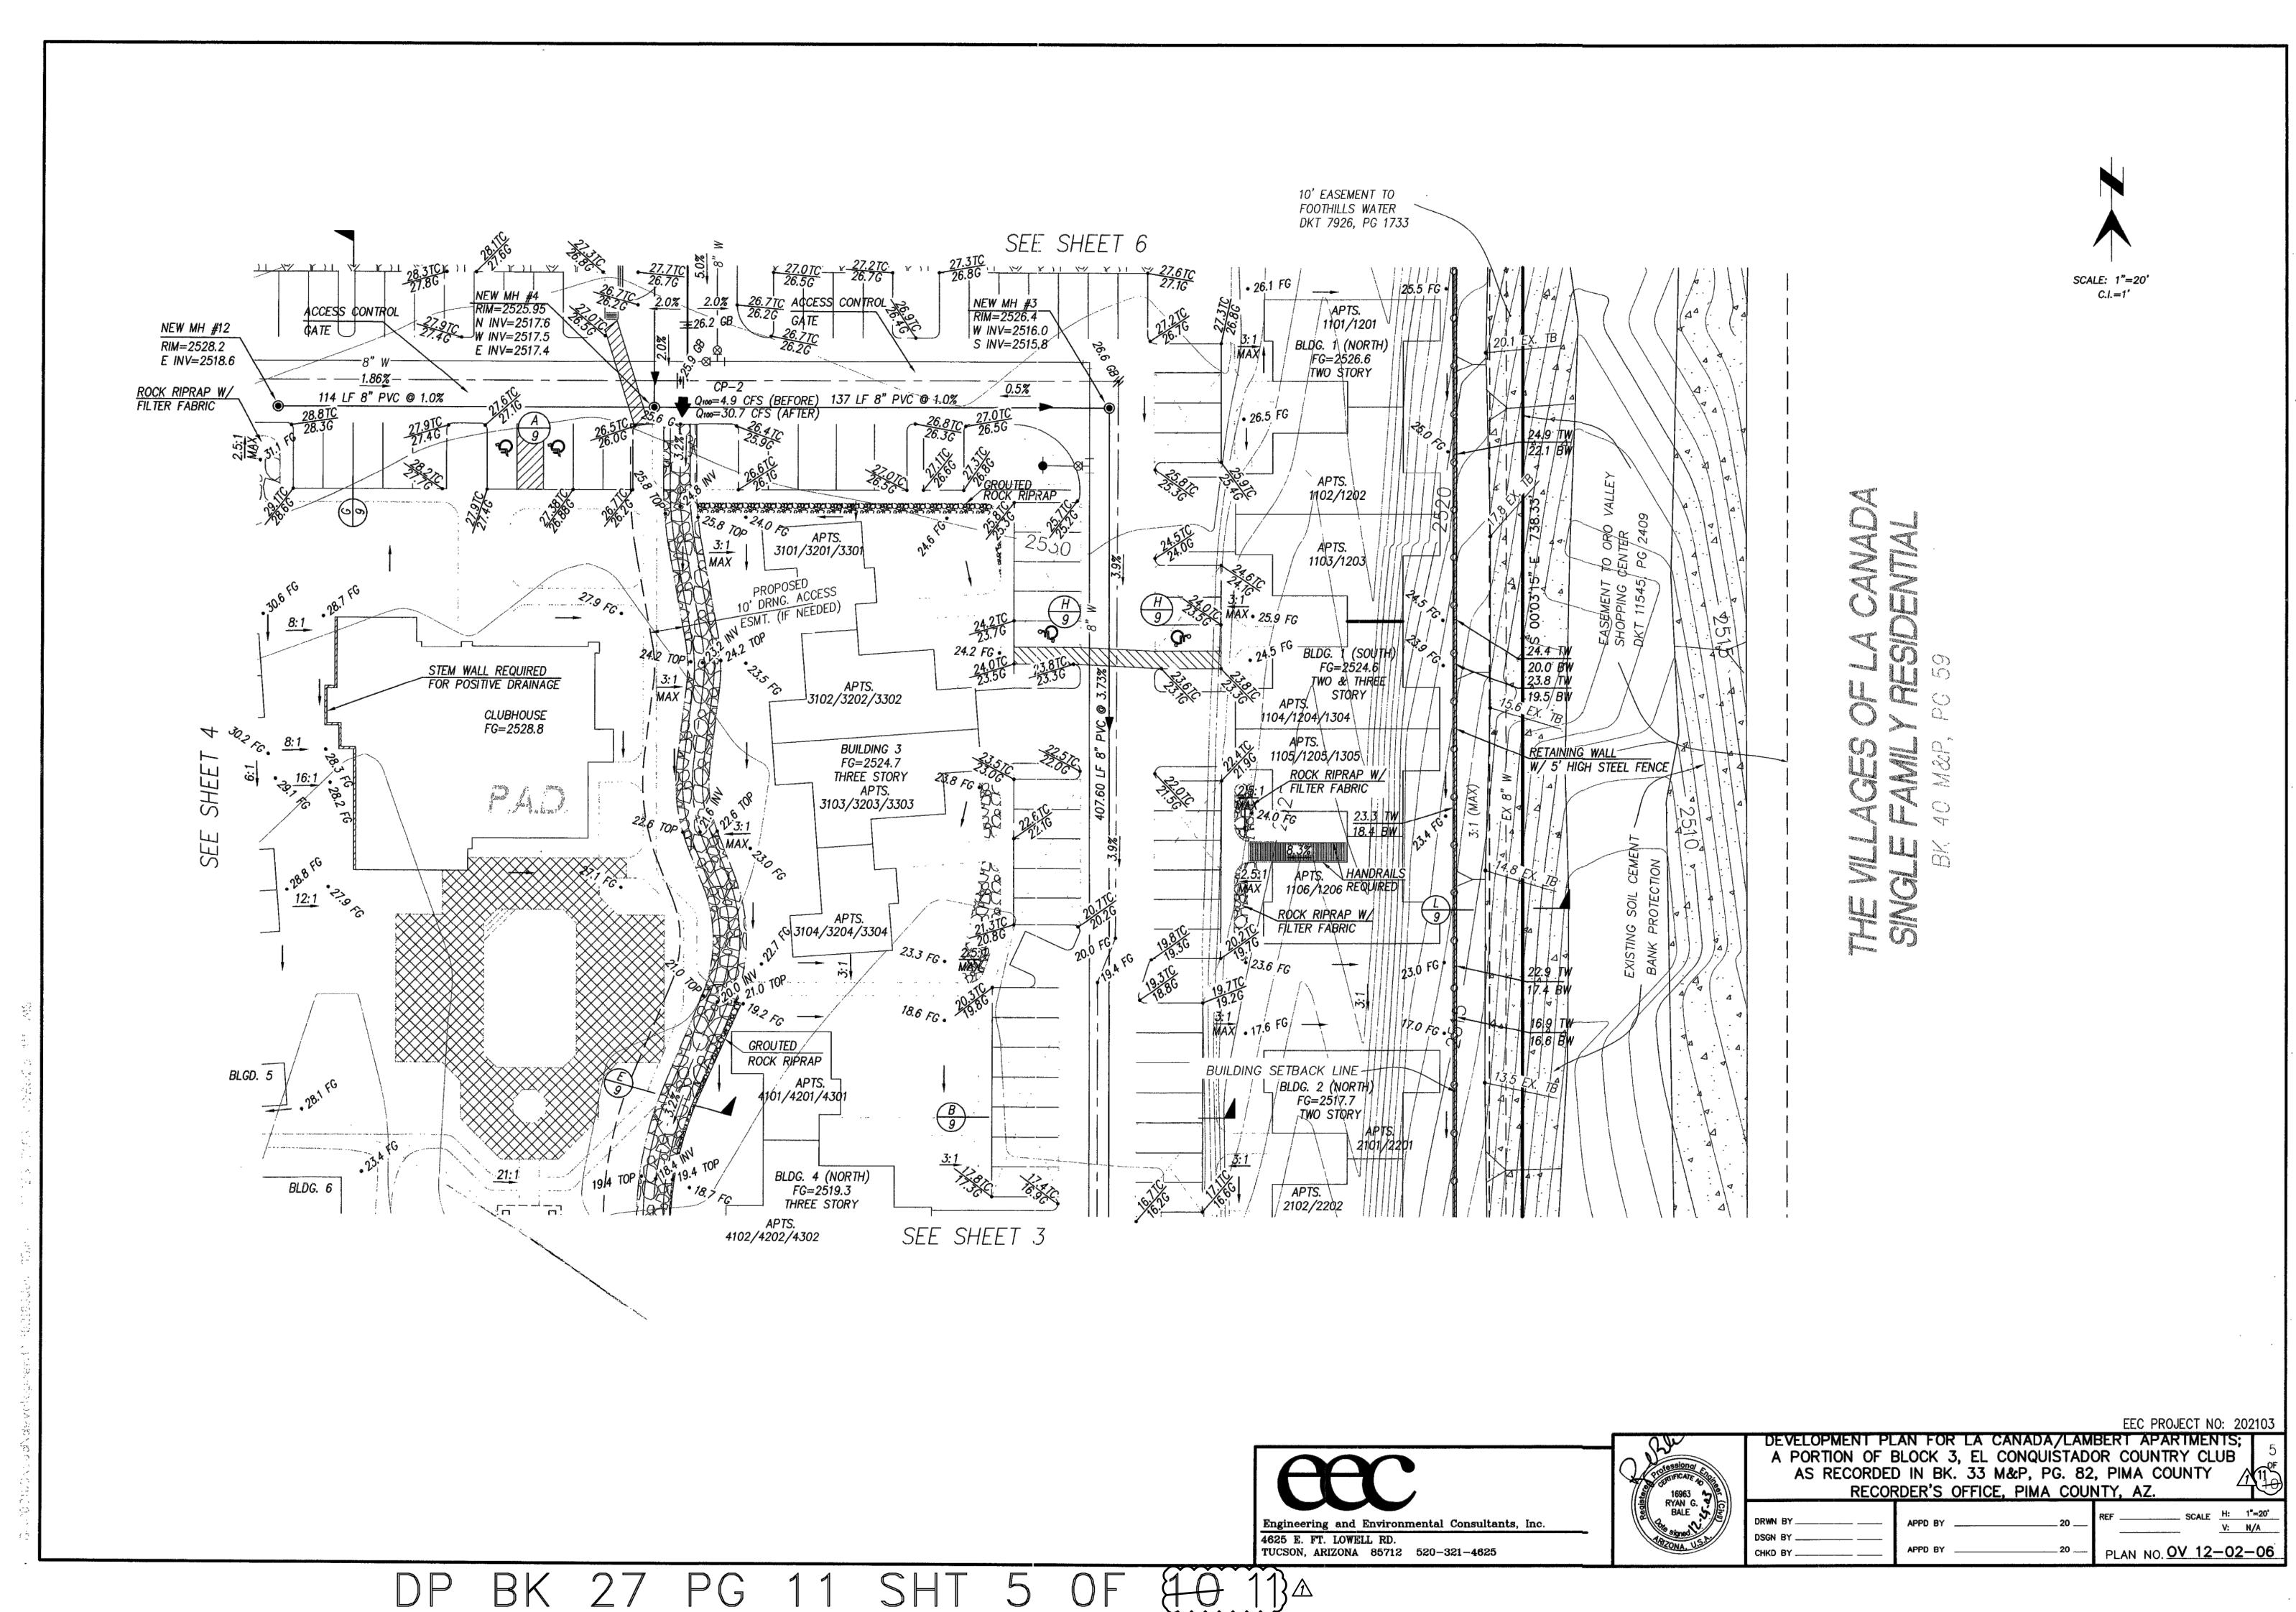

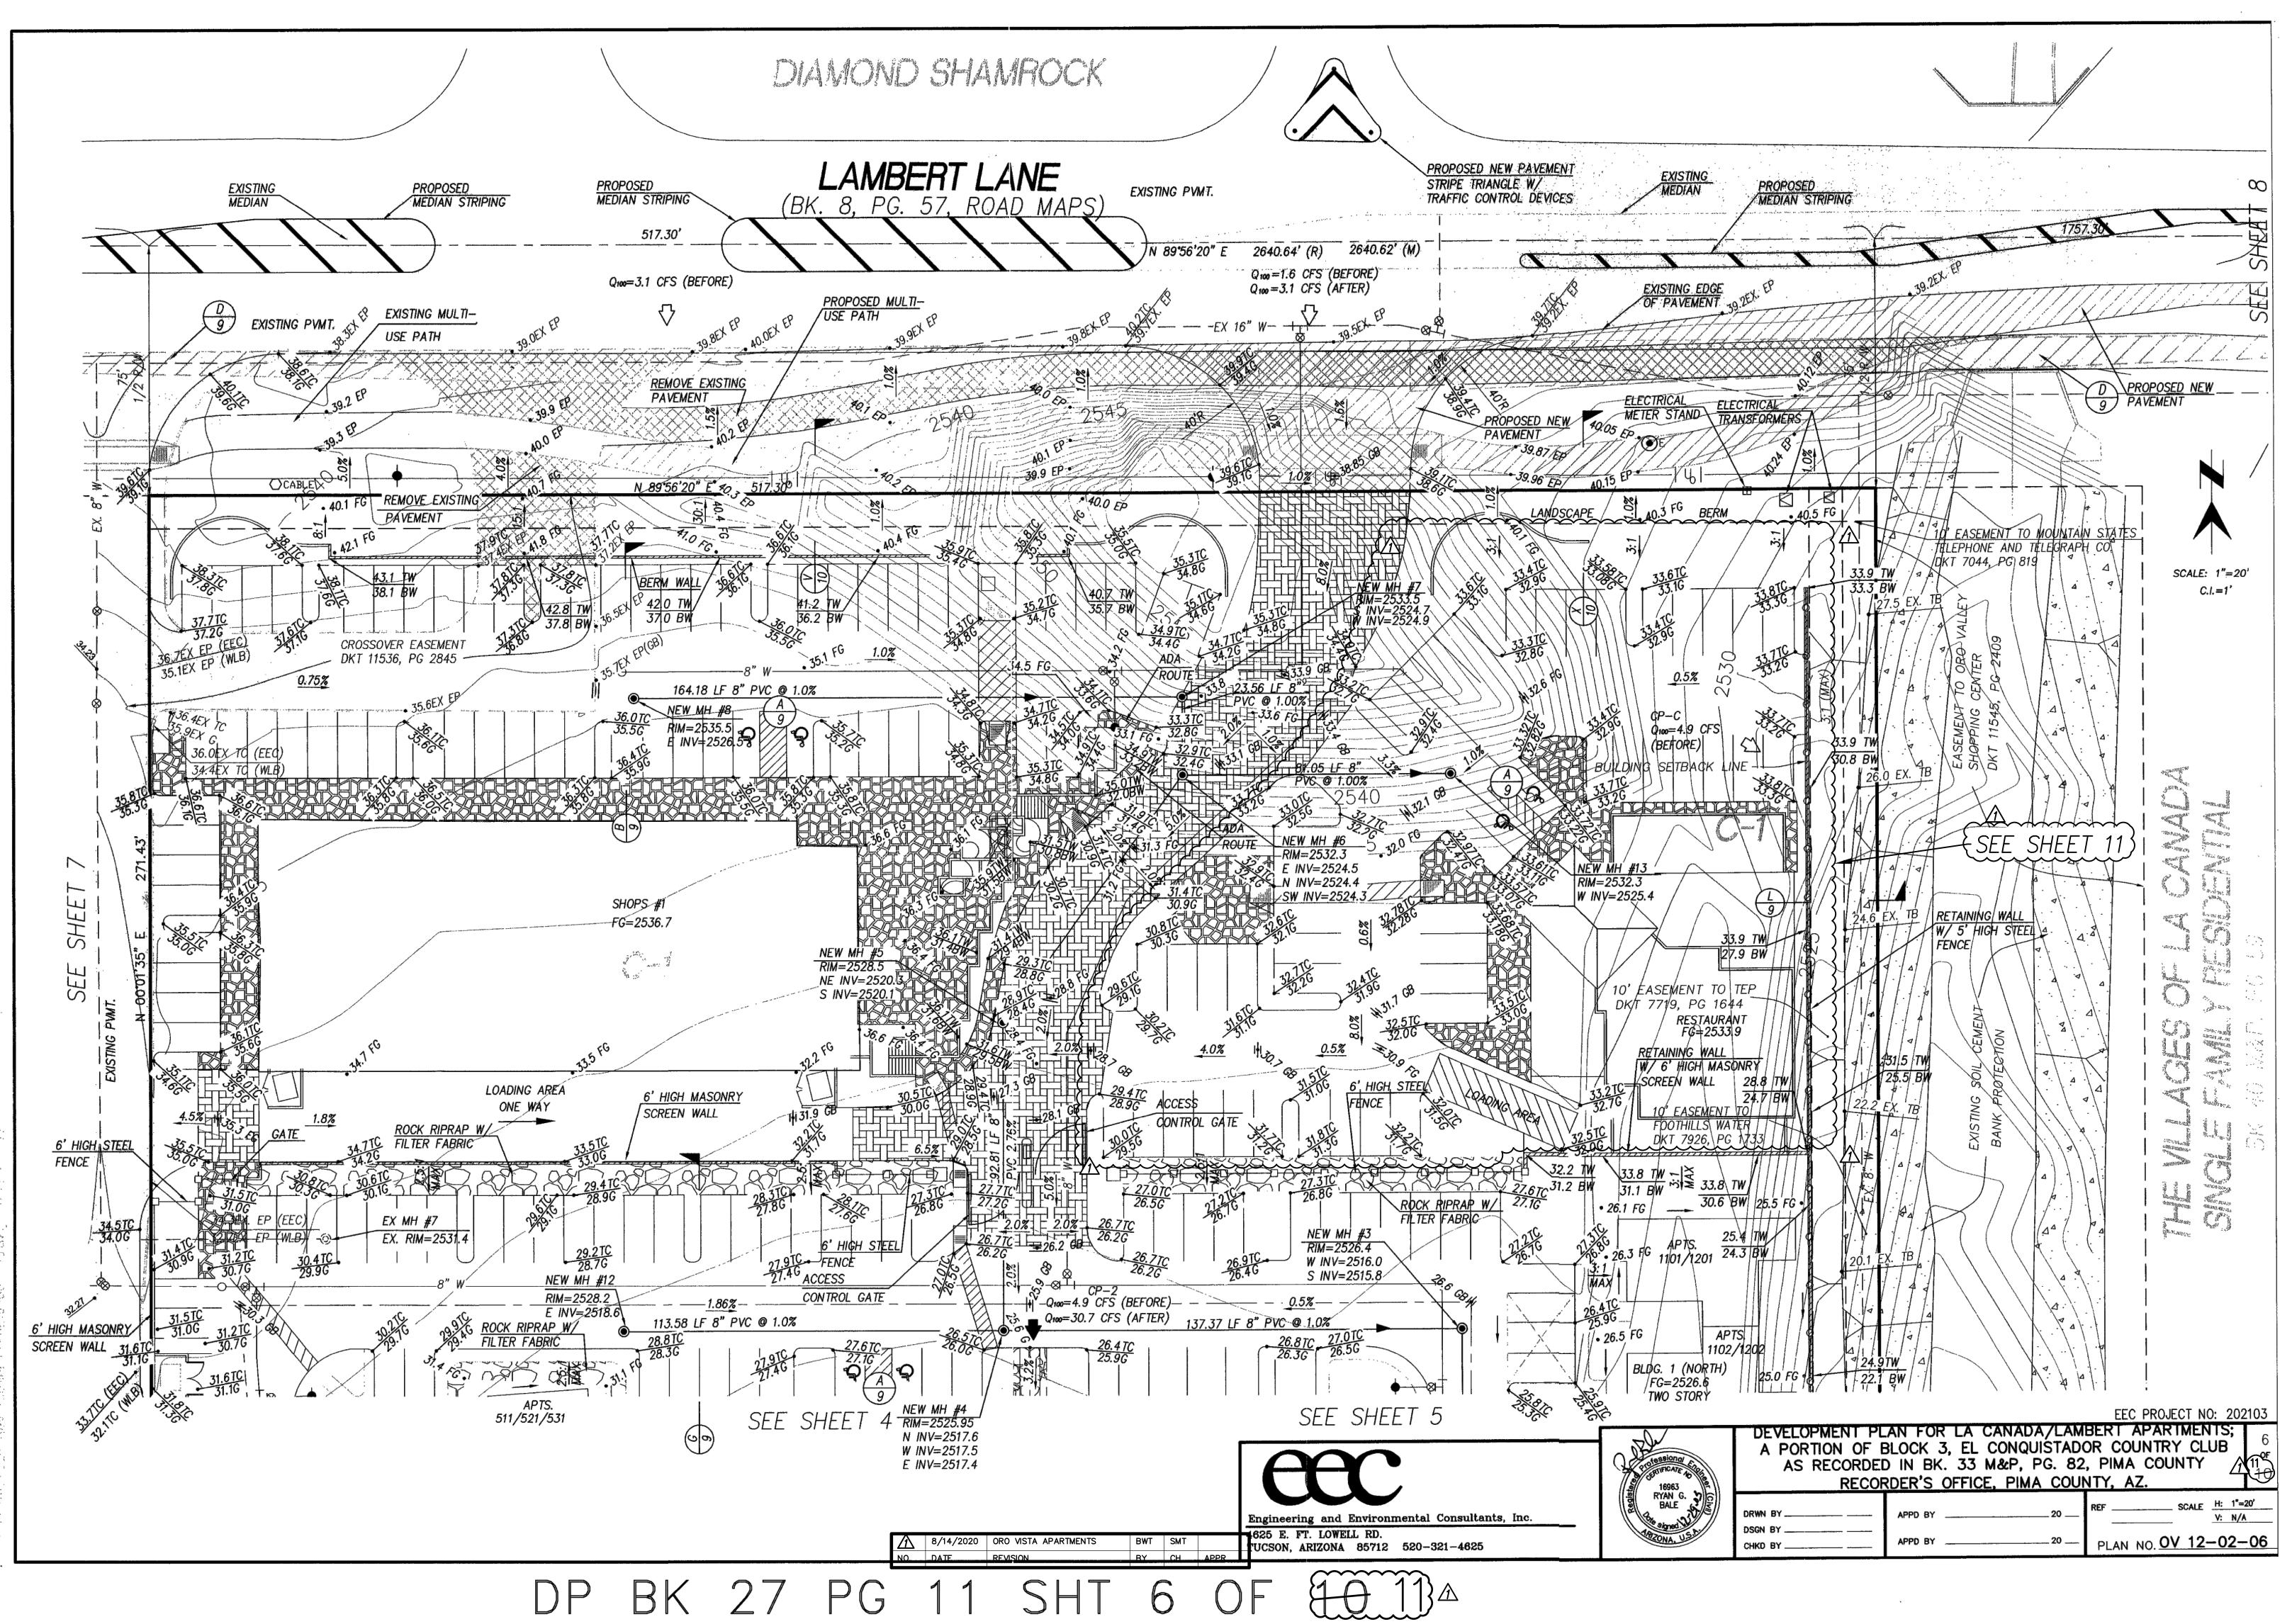

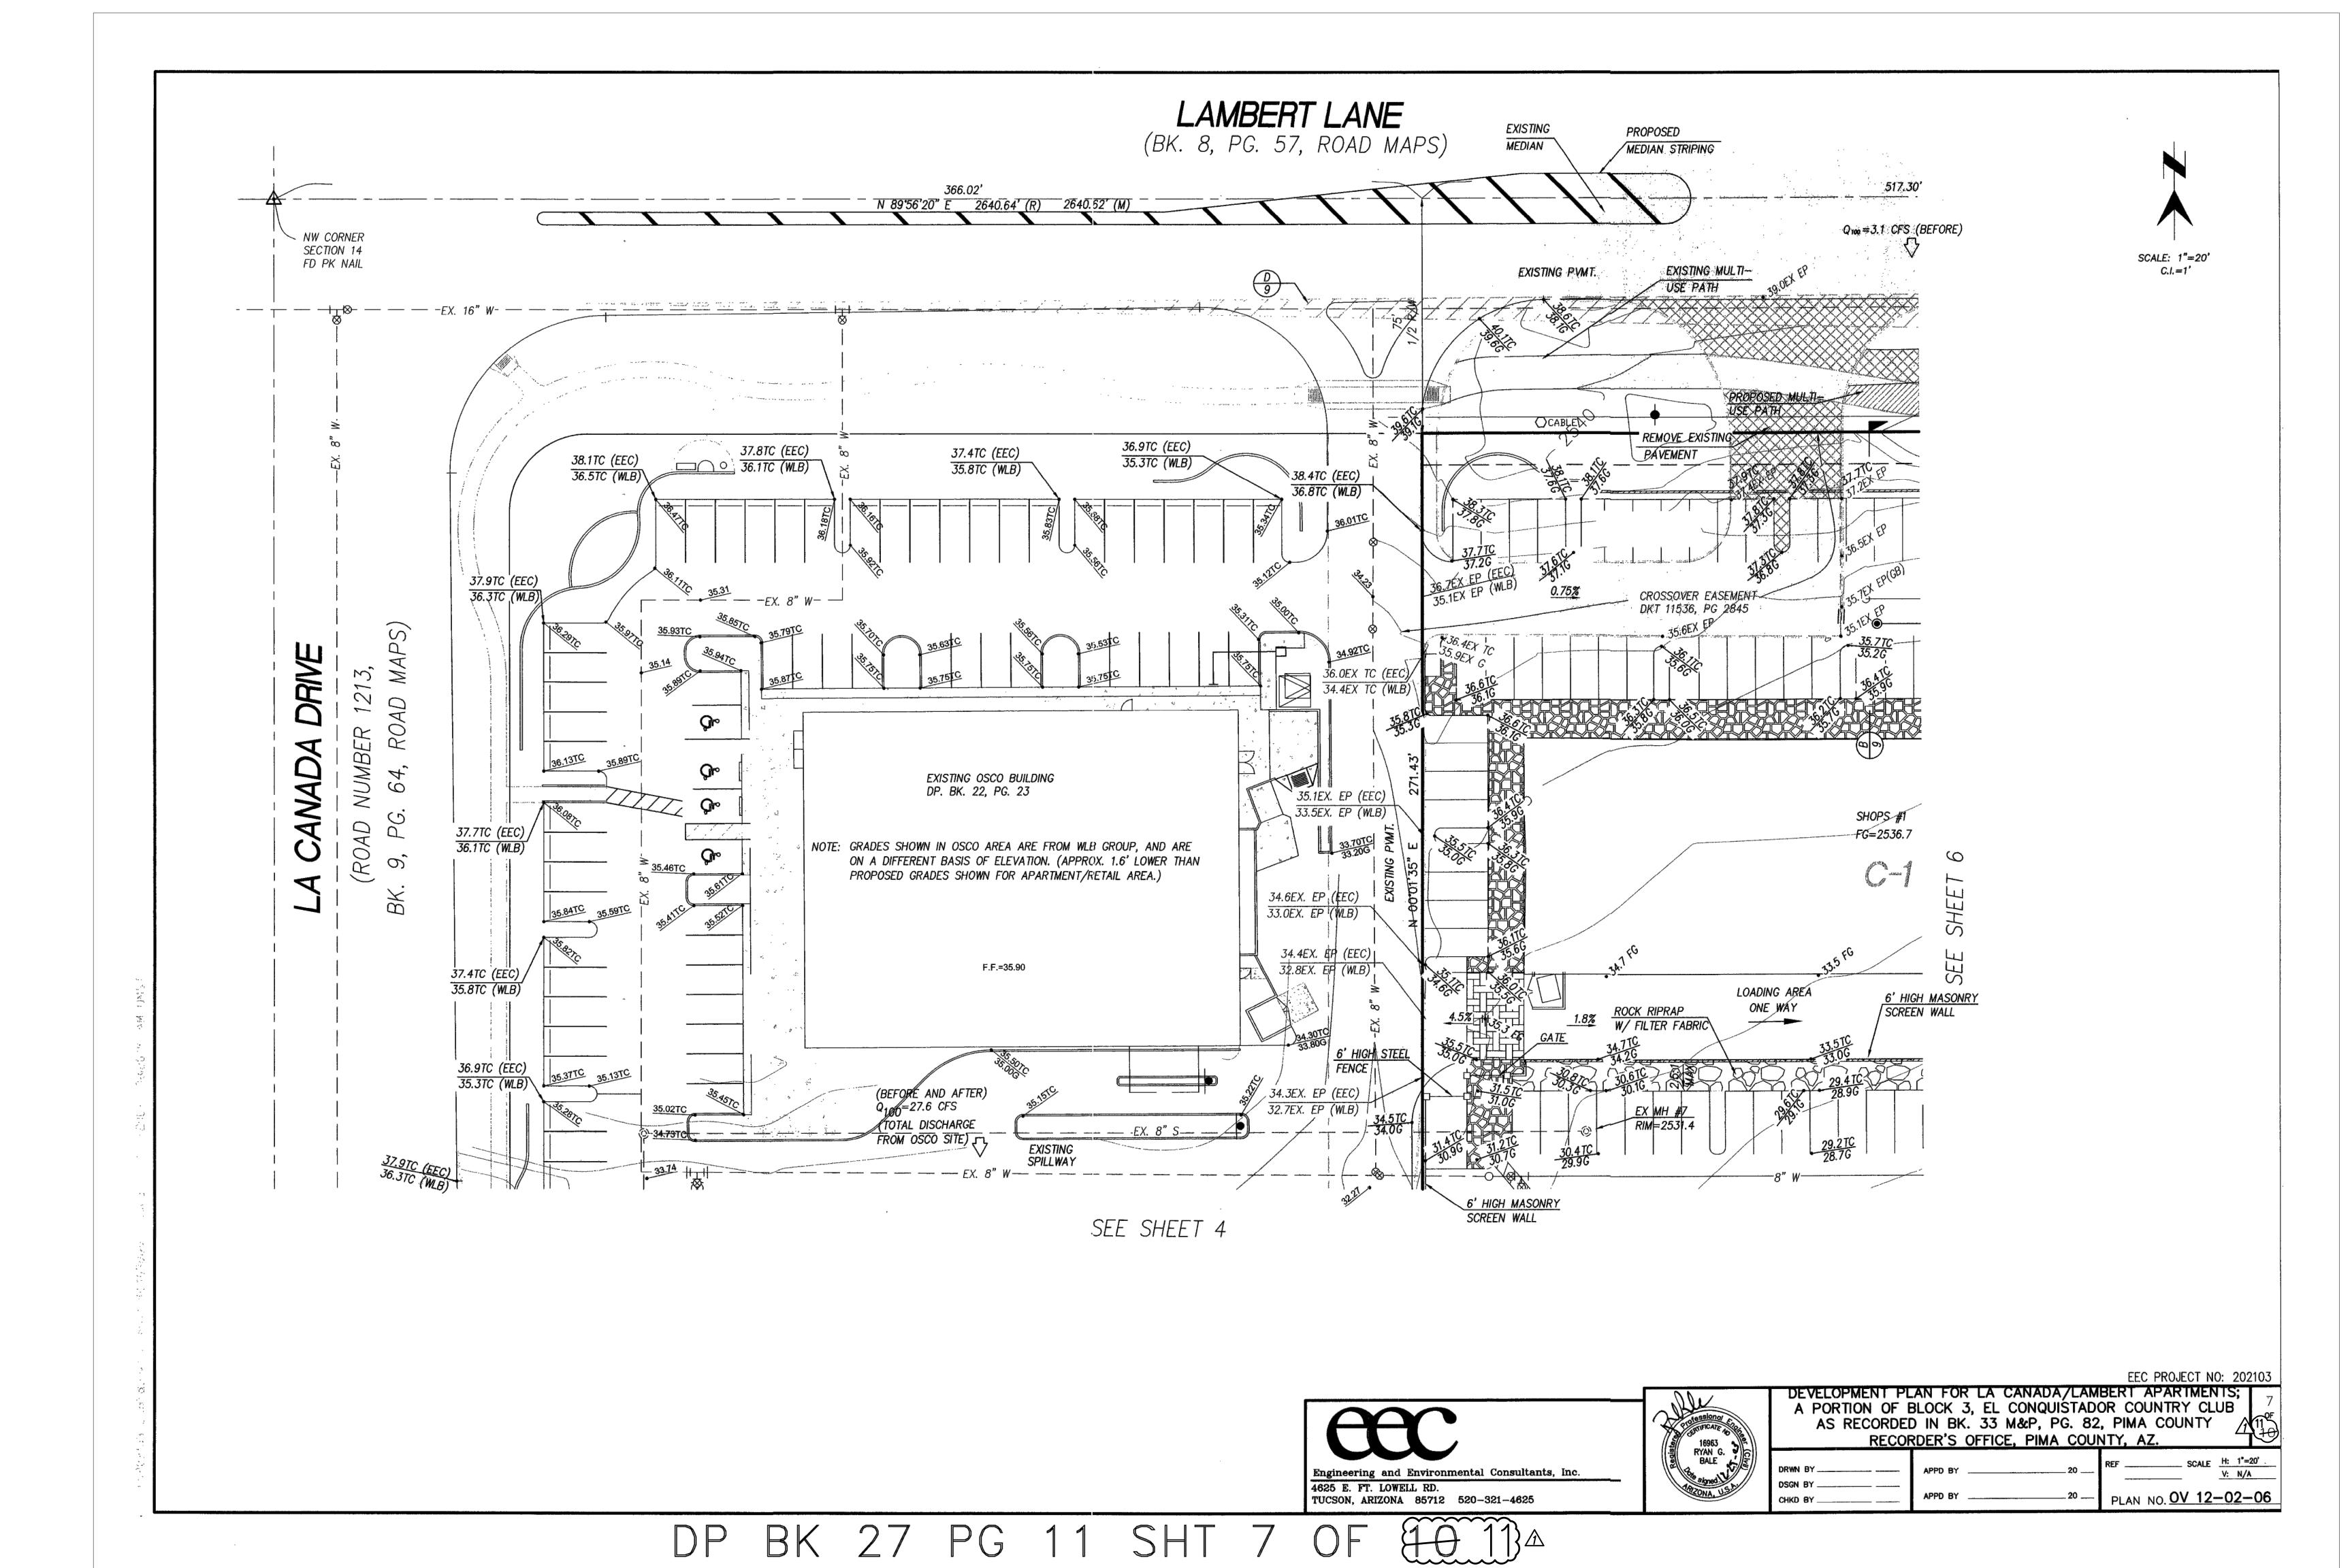

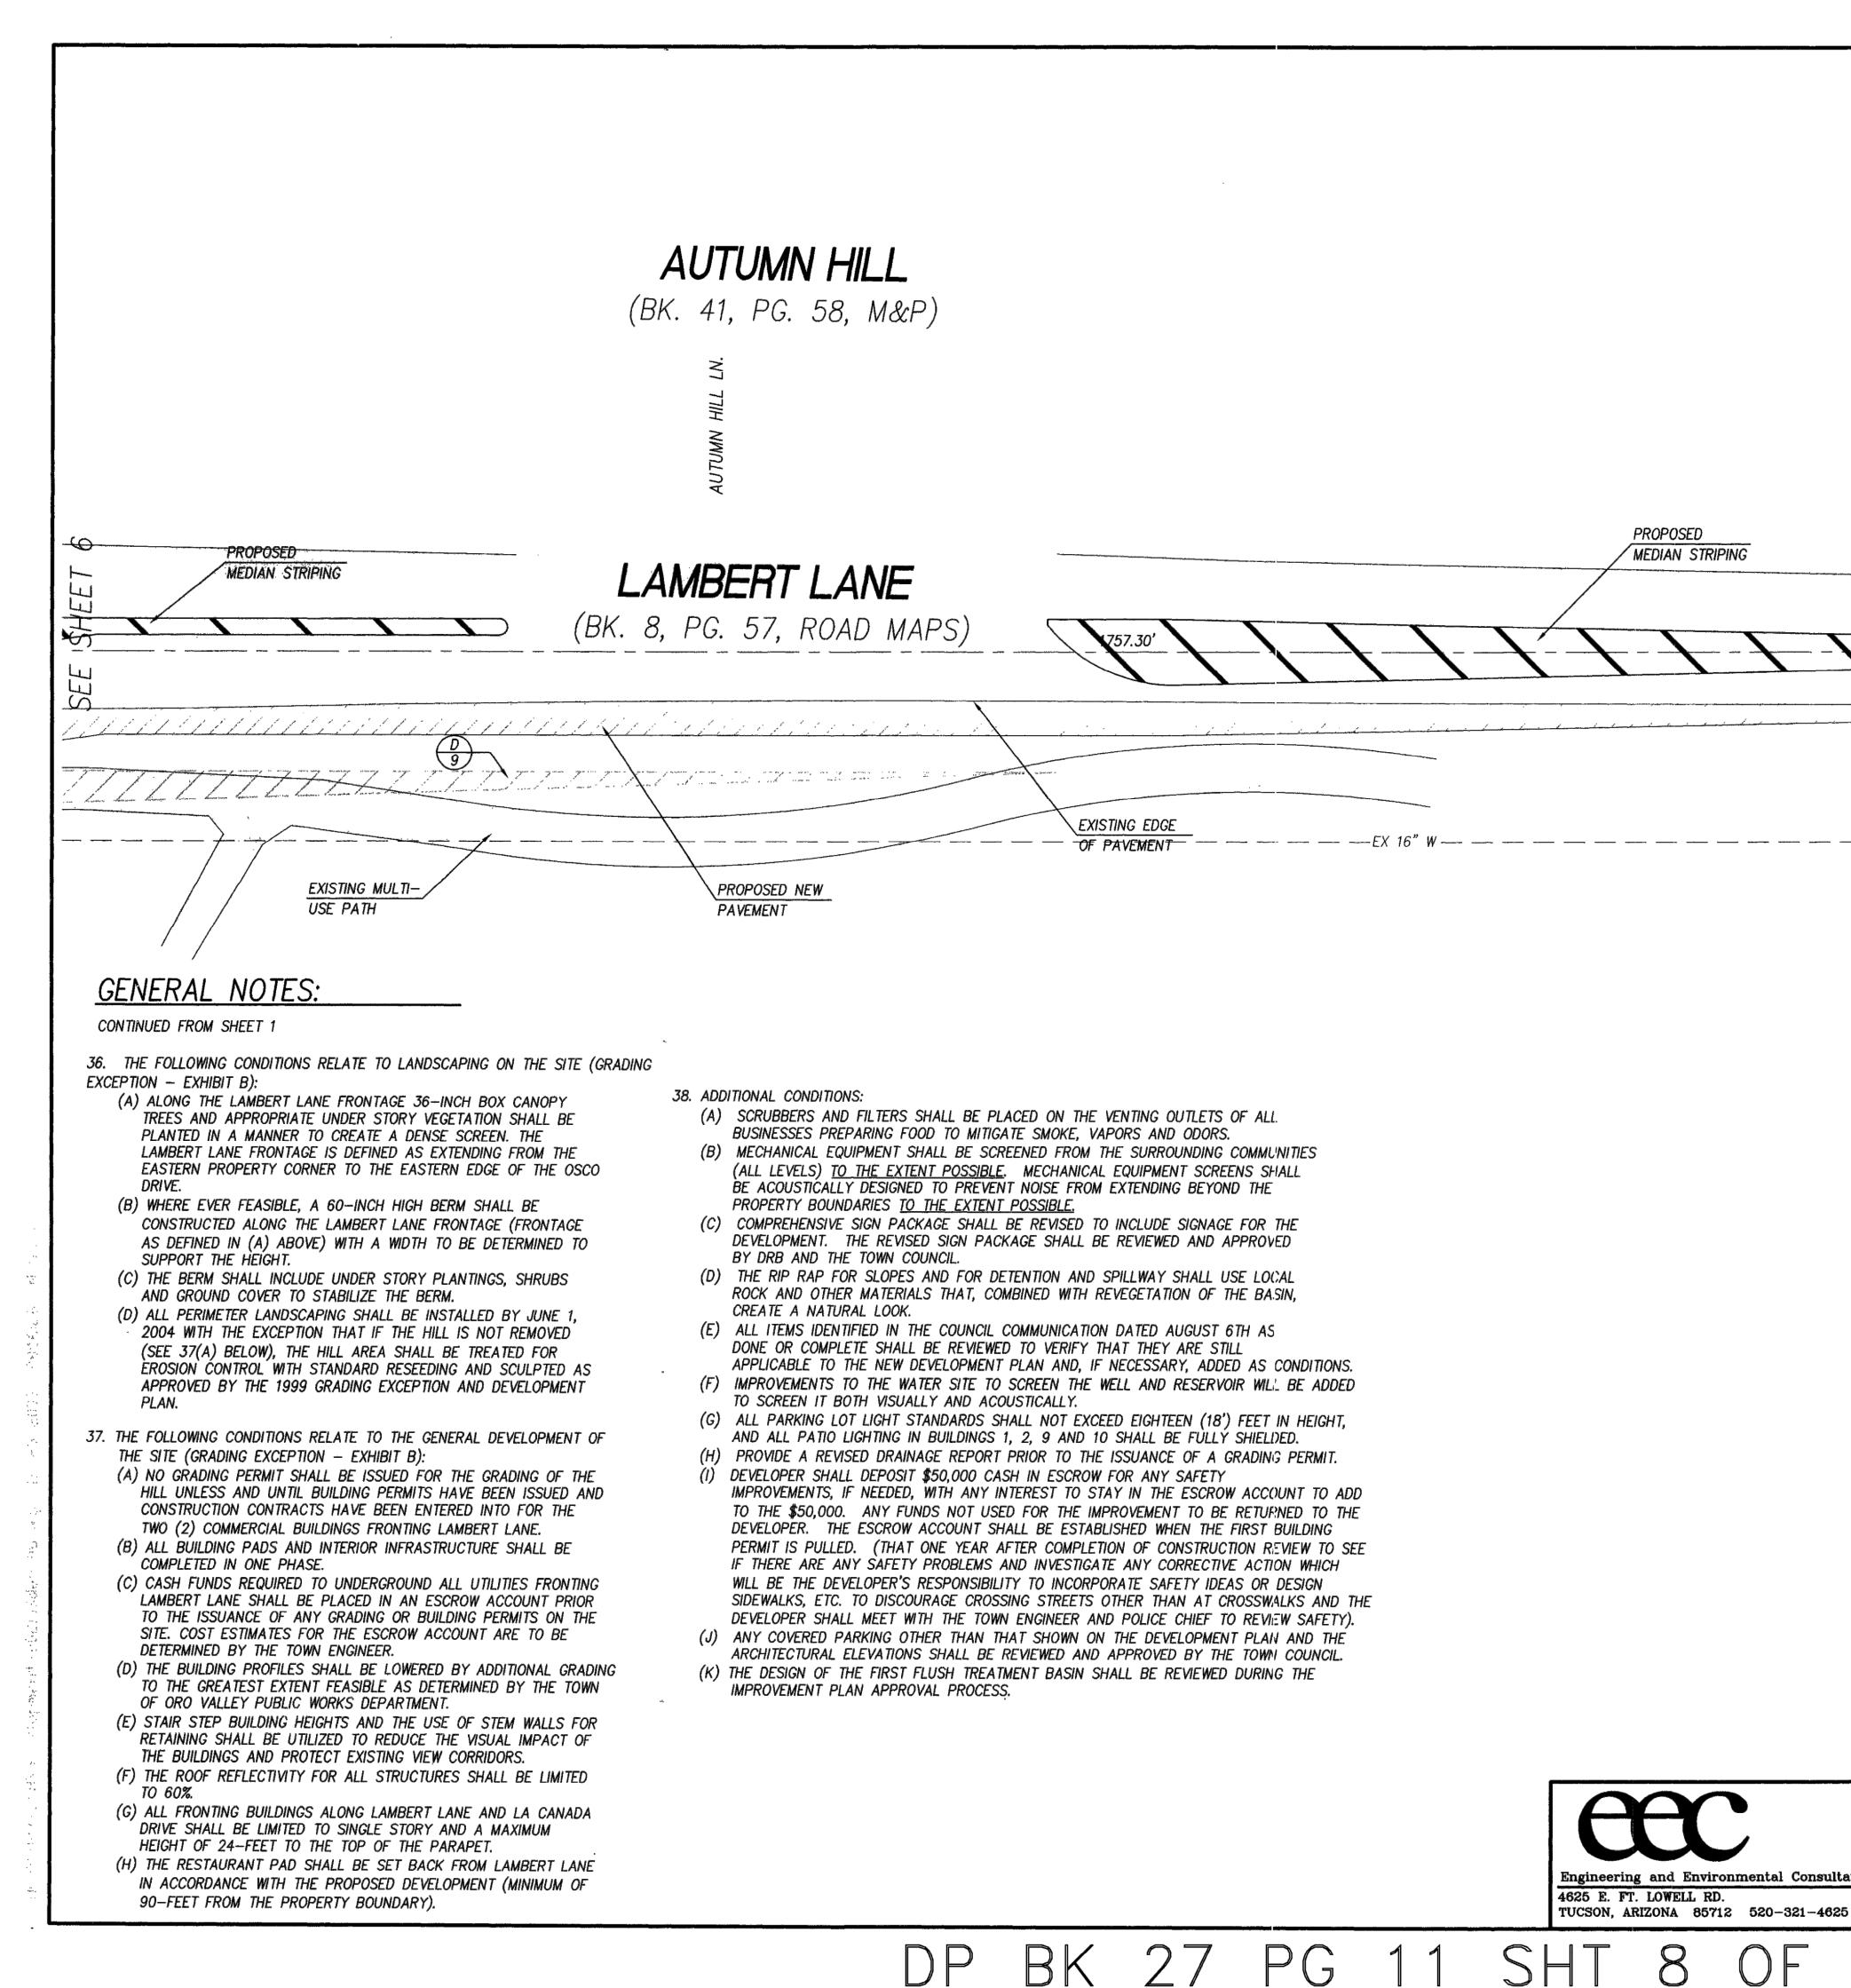


Engineering and Environmental Consultants, Inc. 4625 E. FT. LOWELL RD.


8


PROPOSED

MEDIAN STRIPING

SCALE: 1"=20 C.I.=1'<u>NW 1/4 COR</u> SECTION 14 FD BCSM "PE5955" EEC PROJECT NO: 202103 DEVELOPMENT PLAN FOR LA CANADA/LAMBERT APARTMENTS; APA Protessional A PORTION OF BLOCK 3, EL CONQUISTADOR COUNTRY CLUB AS RECORDED IN BK. 33 M&P. PG. 82. PIMA COUNTY RECORDER'S OFFICE, PIMA COUNTY, AZ, 16963 RYAN G. BALE EF \_\_\_\_\_ SCALE <u>H: 1"=20'</u> DRWN BY \_\_\_\_\_ APPD BY ..... <u>V: N/A</u> DSGN BY \_\_\_\_ APPD BY \_\_\_\_\_ PLAN NO. OV 12-02-06 CHKD BY .....

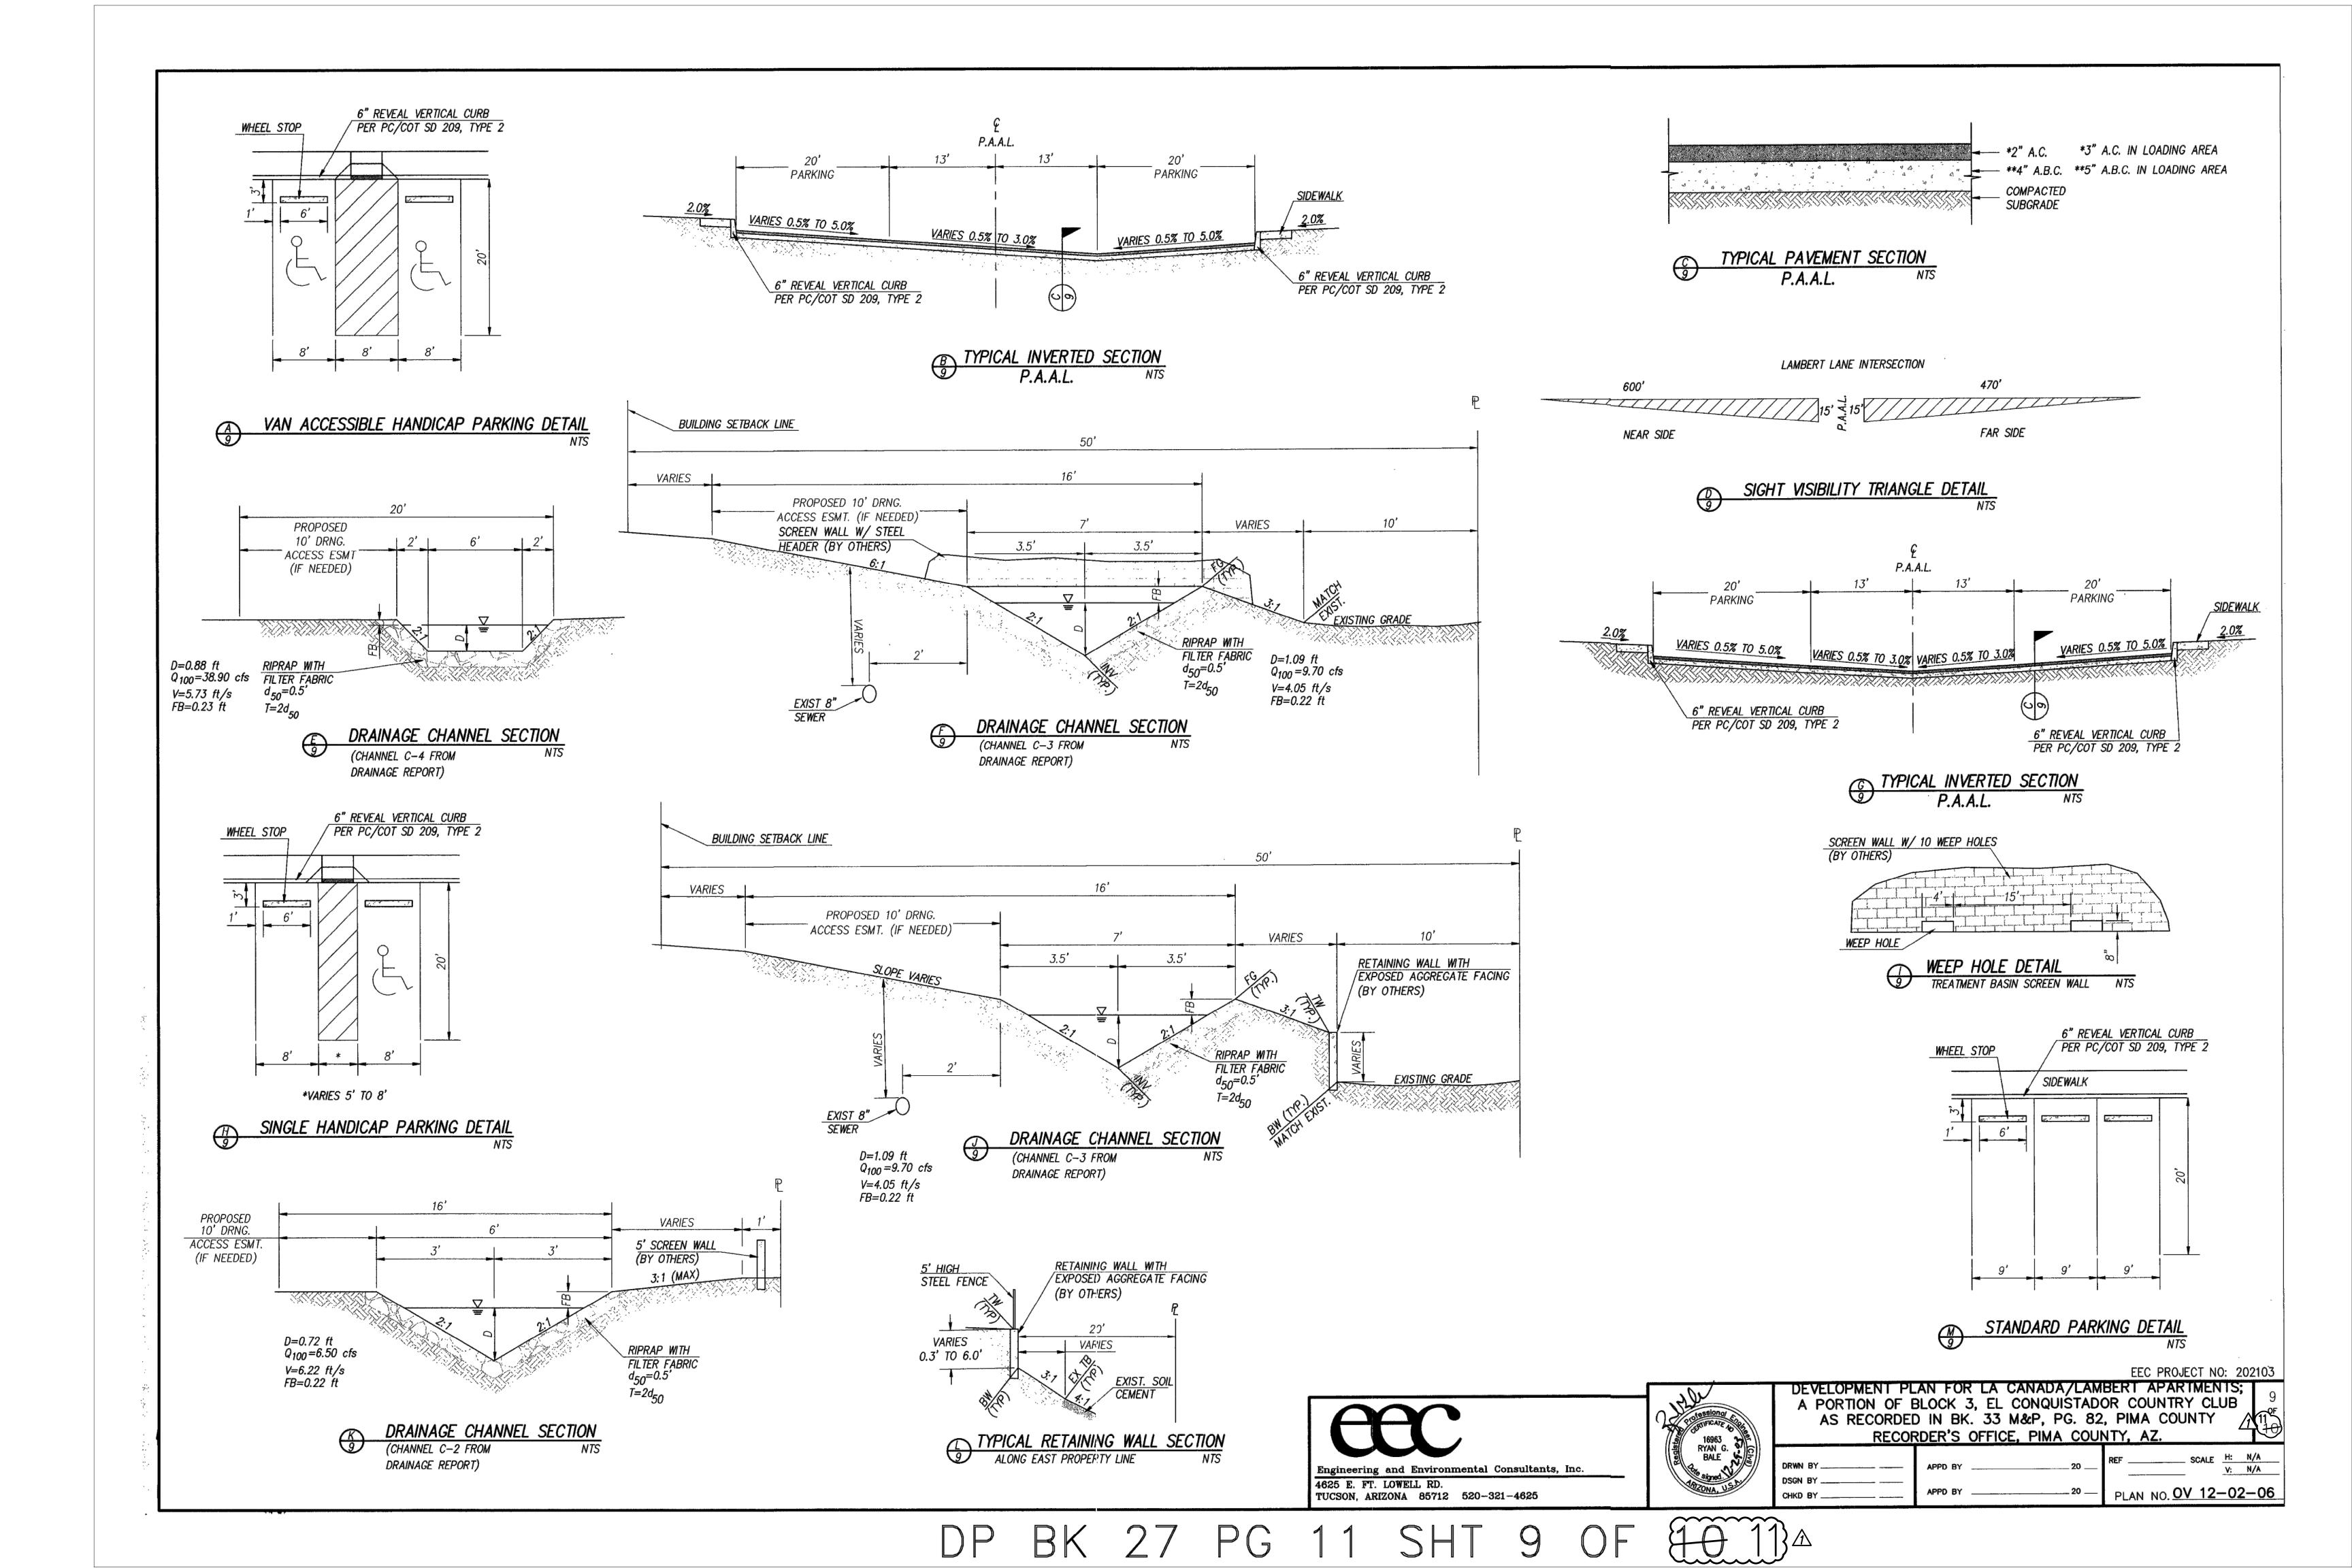

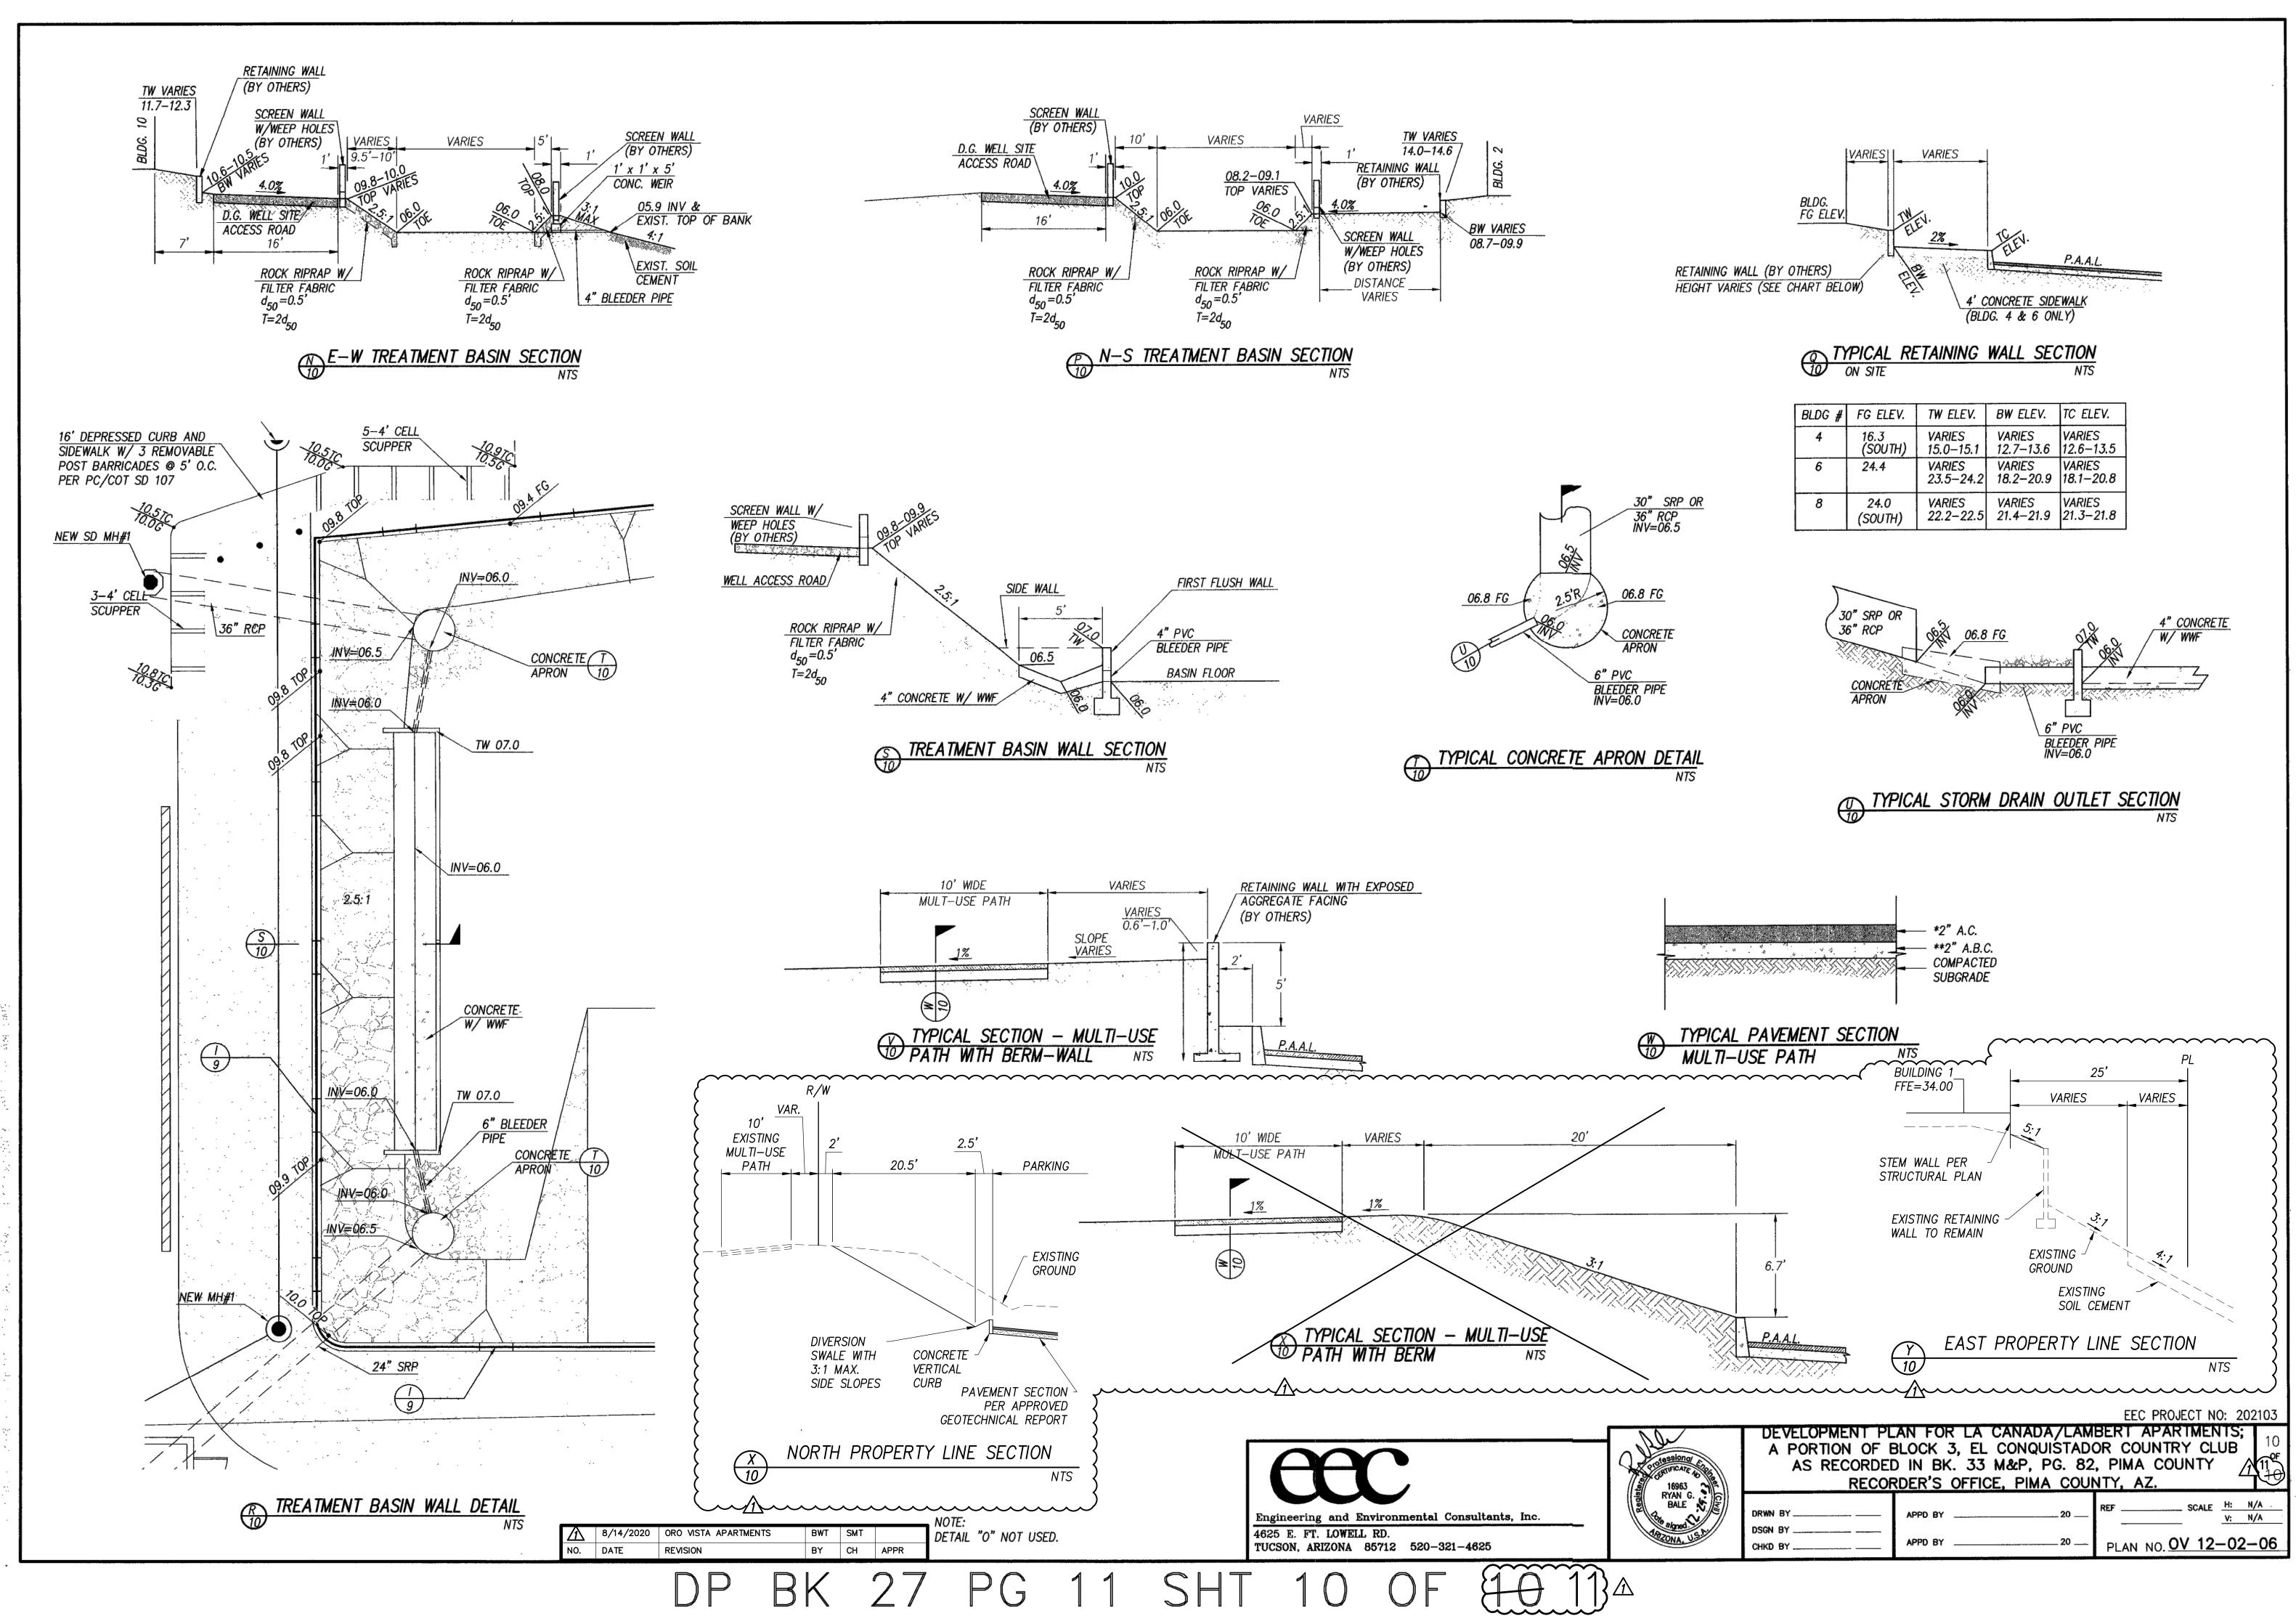

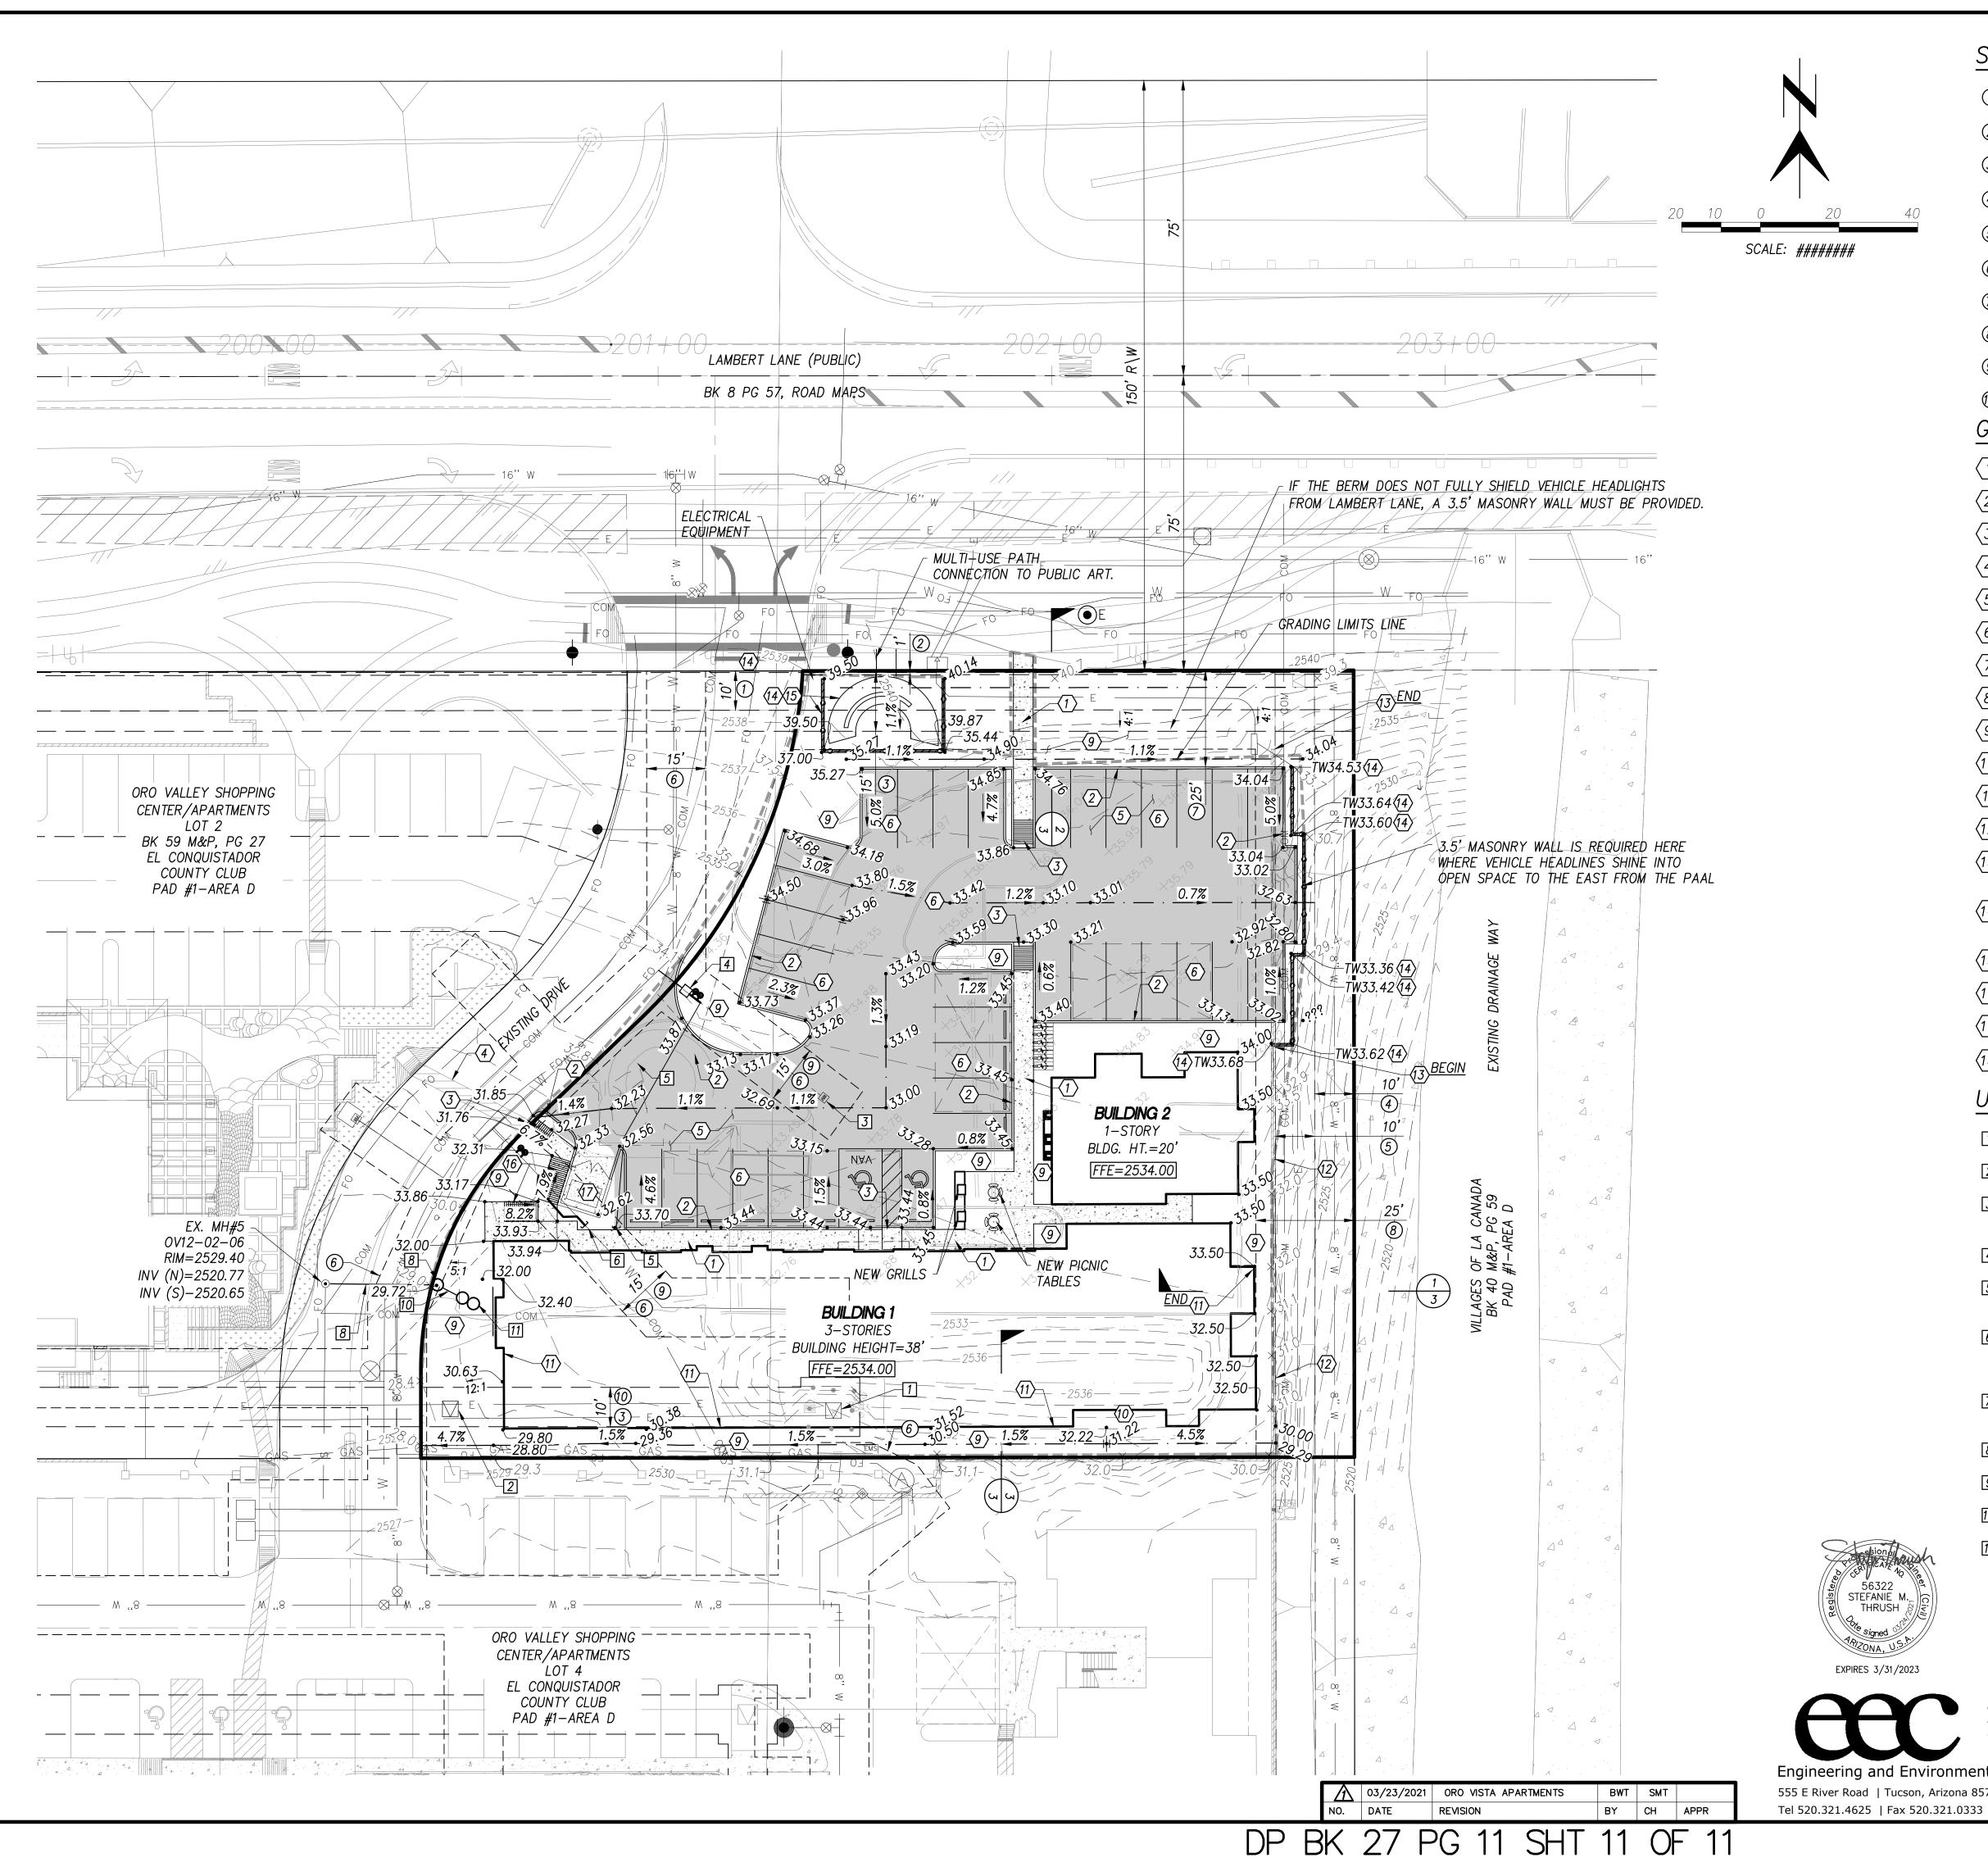

## SITE KEYNOTES

- (1) 10' PUBLIC TELEPHONE EASEMENT DKT. 7044, PG. 819.
- (2) 1' PUBLIC NO ACCESS EASEMENT BK 59, PG 27.
- (3) PUBLIC UTILITY EASEMENT DKT. 12650, PG. 2014.
- ④ 10' PUBLIC FOOTHILLS WATER EASEMENT DKT. 7926, PG. 1733.
- (5) 10' PUBLIC TEP EASEMENT DKT. 7719, PG. 1644.
- 6 PUBLIC INGRESS/EGRESS & UTILITY EASEMENT DKT. 13307, PG. 3455.
- ⑦ 25' BUFFERYARD
- (8) 25' BUILDING SETBACK.
- (9) VACATE WATER EASEMENT AND REMOVE WATER LINE.
- 🔞 VACATE ELECTRIC EASEMENT.

## GRADING KEYNOTES

- $\langle 1 \rangle$  CONCRETE SIDEWALK PER PAG SD 200
- $\langle 2 \rangle$  concrete curb w/6" reveal, type 2, per pag SD 209
- $\langle 3 \rangle$  CURB ACCESS RAMP WITH TRUNCATED DOMES PER PAG SD 207.
- $\langle 4 \rangle$  EXISTING CROSSWALK.
- $\langle 5 \rangle$  PROPOSED PAVEMENT.
- $\langle 6 \rangle$  PROPOSED PARKING.
- $\langle 7 \rangle$  PROPOSED CONCRETE WHEEL STOPS.
- $\langle 8 \rangle$  BICYCLE SPACES.
- $\langle 9 \rangle$  LANDSCAPE AREA (TYP.)
- $\langle 10 \rangle$  NEW HARDSCAPE PER ARCHITECTURAL PLAN.
- $\langle 11 \rangle$  proposed stem wall, height per plan.
- $\langle 12 \rangle$  EXISTING RETAINING WALL TO REMAIN.
- $\langle 13 \rangle$  EXISTING RETAINING WALL TO BE REMOVED AND REPLACED WITH RELOCATED NEW RETAINING WALL.
- $\langle 14 \rangle$  proposed retaining wall, height per plan, with handrail on top of wall PER PAG SD 105.
- (15) EXISTING PUBLIC ART/MONUMENT TO BE RELOCATED IN LOCATION SHOWN.
- $\langle 16 \rangle$  proposed ramp and handrail, see architect plans for details.
- $\langle 17 \rangle$  PROPOSED REFUSE ENCLOSURE.
- $\langle 18 \rangle$  EXISTING SIGN TO BE REMOVED.

## UTILITY KEYNOTES

- 1 EXISTING TRANSFORMER TO BE RELOCATED
- 2 RELOCATED ELECTRIC TRANSFORMER.
- 3 EXISTING WATER METER TO BE RELOCATED. SHORTEN EXISTING SERVICE TO RELOCATED METER LOCATION. INSTALL BACKFLOW PREVENTER.
- [4] RELOCATED WATER METER.
- 5 PROPOSED PRIVATE WATER SERVICE LINE, STUB 5' FROM BUILDING, SEE PLUMBING PLANS FOR CONTINUATION.
- 6 REMOVE EXISTING FIRE LINE BACK TO 5' FROM BUILDING AND REROUTE AROUND NEW TRASH ENCLOSURE. INSTALL BACKFLOW PREVENTER. SEE PLUMBING PLANS FOR CONTINUATION INTO BUILDING.
- 7 CONNECT NEW HCS TO EXISTING MH#5 PER PC RWRD SD 402. NEW INV=2521.00.
- 8 PROPOSED PRIVATE 28.44 LF HCS @ 2.00% SLOPE
- 9 PROPOSED PRIVATE SINGLE CLEANOUT, HCS INV=2521.57.
- 10 PROPOSED PRIVATE 10.33 LF HCS @ 2.00% SLOPE.
- 11 PROPOSED DOUBLE CLEANOUT 5' FROM BUILDING, HCS INV=2521.78, SEE PLUMBING PLANS FOR CONTINUATION.

civil engineering • land development surveying • environmental services staking • flood control and drainage transportation

A PORTION OF LA CANADA/LAMBERT RETAIL CENTER, SECTION 14, T 12 S, R 13 E, G&SRM, TOWN OF ORO VALLEY, PIMA COUNTY, ARIZONA

MASTER DEVELOPMENT PLAN

FOR

ORO VISTA APARTMENTS

Engineering and Environmental Consultants, Inc. 555 E River Road | Tucson, Arizona 85704

CONTOUR INTERVAL = 1 FOOTMARCH 2021 EEC JOB NO 20004

*REF CASE: 0V12–02–06* SCALE: 1"= 20' SHEET 11 OF 11